



ADDENDUM NO. 03 February 16, 2022

To Drawings and Specifications dated February 2, 2022.

FRIENDSWOOD HIGH SCHOOL ADDITIONS & RENOVATIONS FOR FRIENDSWOOD I.S.D.

Prepared by: PBK

11 Greenway Plaza, 22nd Floor Houston, TX 77046-1104 PBK Project No: 20381

Notice to Bidders

A. Receipt of this Addendum shall be acknowledged on the Bid Form.

B. This Addendum forms part of the Contract documents for the above referenced project and shall be incorporated integrally therewith.

C. Each bidder shall make necessary adjustments and submit his proposal with full knowledge of all modifications, clarifications, and supplemental data included therein. Where provisions of the following supplemental data differ from those of the original Contract Documents, this Addendum shall govern.

SPECIFICATIONS

Item No. 1 Section 08 56 59: Horizontal Transaction Windows: Add section in its entirety.

DRAWINGS

Item No. 2	Sheet A-101Q: Provide CMU column wraps at columns Q8-QG, Q8-QK, QK-Q7.1, and QK-Q6.5.
Item No. 3	Sheet A-101R1: Replace sheet in its entirety.
Item No. 4	Sheet A-101R: Replace sheet in its entirety.
Item No. 5	Sheet A-101S: Replace sheet in its entirety.
Item No. 6	Sheet A-101T: Revise Set Construction Shop layout to show equipment. Refer to SK-01.
Item No. 7	Sheet A-102Q: Revise Concessions plan to accommodate mechanical chase wall. Refer to SK-02.
Item No. 8	Sheet A-102R: Replace sheet in its entirety.
Item No. 9	Sheet A-102S: Replace sheet in its entirety.
Item No. 10	Sheet A-201R: Replace sheet in its entirety.
Item No. 11	Sheet A-201S: Replace sheet in its entirety.
Item No. 12	Sheet A-202R: Replace sheet in its entirety.
Item No. 13	Sheet A-202S: Replace sheet in its entirety.
Item No. 14	Sheet A-301: Replace sheet in its entirety.
Item No. 15	Sheet A-302: Replace sheet in its entirety.
Item No. 16	Sheet A-303: Replace sheet in its entirety.
Item No. 17	Sheet A-304: Replace sheet in its entirety.
Item No. 18	Sheet A-306: Replace sheet in its entirety.
Item No. 19	Sheet A-307: Replace sheet in its entirety.
Item No. 20	Sheet A-404: Replace sheet in its entirety.
Item No. 21	Sheet A-405: Replace sheet in its entirety.
Item No. 22	Sheet A-423: Replace sheet in its entirety.
Item No. 23	Sheet A-501: Replace sheet in its entirety.
Item No. 24	Sheet A-502: Replace sheet in its entirety.
Item No. 25	Sheet A-504: Replace sheet in its entirety.
Item No. 26	Sheet A-510: Replace sheet in its entirety.
Item No. 27	Sheet A-513: Replace sheet in its entirety.

- Item No. 28 Sheet A-517: Add sheet in its entirety.
- Item No. 29 Sheet A-623: Replace sheet in its entirety.
- Item No. 30 **Sheet A-625:** Replace sheet in its entirety.
- Item No. 31 Sheet A-842:
 - a) Add overhead door at 09/M102 Concessions South elevation. Refer to SK-03.
 - b) Revise Locker Type C size to be 12" W x 18" D x 72" H.
 - c) Revise Locker Type D to be single tier. Provide 4" concrete curbs under Locker Type D.
- Item No. 32 **Sheet A-845:** Replace sheet in its entirety.
- Item No. 33 Sheet A-847: Add sheet in its entirety.
- Item No. 34 Sheet AF101: Update exterior finish schedule to match exterior finish material legends. Refer to SK-04.

QUESTIONS

- Item No. 35 Sections 13 20 00 or 13 21 48 are both calling for the same thing, which is to be used for bid? What rooms are these? Answer: Section 13 21 48 to be used. This is for Practice Room 1009D on sheet A-101H.
- I noticed that some of the frames on page A-101S are not labeled. I did see that they are in line with frames on A-101R and seem to be the same to me. The frames in question are R100G, R100H, R100J,R100K, R100L and frame R100M. I needed to know if these would be aluminum frames or not. Answer: They are aluminum storefront window system.
- Item No. 37 There is a required list of subs in the specifications for us to list in section 00 20 00-6 1.16 "list of sub-contractors" and an entirely different list in the pre-bid agenda for us to list. Which list do you prefer? Answer: Submit the list of subcontractors on the pre-bid agenda.
- Item No. 38 **Who is responsible for furniture moving?** Answer: The owner will move any furniture as necessary.
- Item No. 39 Sheet G-011 calls out the Tennis Court Building to be 100% fully sprinkled. The Civil Drawings do not show a fire line to service the building. Please advise. Answer: The tennis building is not intended to have a sprinkler system. Sheet G-011 to be revised to show the tennis building not be sprinkled.
- Item No. 40 The Landscape Drawings call out W4 in several locations. The legend on Sheet L2.00 list W4 as not used. Answer: Refer to Addendum 02 Sheet L2.00.
- Item No. 41 The Project Manual includes Spec Section 07 81 23 Intumescent Fireproofing. Where is this required in lieu of sprayed fireproofing? Answer: At the Performing Arts Center and Gymnasium lobbies where the columns exposed. Also, use at the Performing Arts Center exterior canopy columns refer to sheet A-101R and A-101S.
- Item No. 42 On page A-306 cut through 10/A-604 at the junction of roofs P1 and Q1 (different elevations) shows a roof-to-wall expansion joint detail, however detail 20/A-322 also shown shows a roof-to-roof expansion joint. Please advise. Answer: Detail tagged incorrectly. Refer to 3/A322. Refer to revised A-300 series drawings.
- Item No. 43 There appears to be numerous discrepancies between the roof nomenclatures, and the hatching for tapered insulation/crickets. Examples roof areas D2, D6, F4, B1... Answer: Remove hatching from areas D2,3,6. E2. C2,3. F4,5. B1. Refer to revised A-300 series drawings.
- Item No. 44 At the site visit roof areas A1 and B1 appeared to be identical. Roof drains appear to be missing on A1 and there appear to be more drains than existing on B2. Is this correct? What is the drainage design for A1? Answer: Correct. Drains need to be added. Will reflect B1. Refer to revised A-300 series drawings.
- Item No. 45 New roof nomenclatures A, F, G, D, I, J, etc. show a mechanically attached base sheet on top of the coverboard. Is this correct? Answer: Yes. Refer to revised A-300 series drawings.
- Item No. 46

 New roof nomenclature K shows a vented base sheet over the concrete deck. How is this to be attached. Additionally, it shows mechanically attached insulation over the concrete deck. Is this correct? Answer: Slip sheet in lieu of vented base sheet. Fully adhere full system in lieu of mechanically fastened. Refer to revised A-300 series drawings.
- Item No. 47 Please verify the hatched area on the lower right of roof area J1 is to receive tapered insulation. Answer: Confirmed. Refer to revised A-300 series drawings.
- Item No. 48 Page A-304 area H1 detail 11/A322 appears to be incorrect. Please advise. Answer: Detail should read 11/A323. Refer to revised A-300 series drawings.

- Item No. 49 Sheet ES105 does not show electrical power to the irrigation booster pump. Answer: There is no irrigation booster pump in the project.
- Item No. 50 The proposal form requires the GC to list over twenty of the proposed subcontractors. Is it acceptable to list more than one for each scope of work? Answer: Only one subcontractor per scope of work will be allowed.
- Item No. 51 Due to the number of disciplines, can the proposed subcontractor's list be turned in with the alternate pricing? Answer: The subcontractor list is due with the Alternate Proposal form, as noted at the bottom of the subcontractor list form.
- Item No. 52 The Intrusion Detection system indicates to provide sounder / strobes at each exterior door and tie back to the access control system to monitor door ajar. I'm not sure if this a Friendswood ISD requirement since there are no sounder shows on the plans. Answer: For the intrusion detection, the sounders are not a district standard and are not reflected on the drawings, please disregard.
- Item No. 53

 The video surveillance system shows symbols on the drawings for 360* cameras for both indoor / outdoor applications. The specifications indicated using multi-sensor cameras for both indoor / outdoor to achieve the 360* view, but the specifications also indicate and indoor 360* fisheye camera that could be used since this camera is also rated for outdoor use. There is a significant price difference between multi-sensor cameras and single lens 360* Answer: For the Cameras, in Addendum #2 the district clarified what they want to use.
 - Exterior Axis P3717-PLE multi-sensor camera.
 - Interior Fixed Axis P3245-LV.
 - Exterior Fixed Axis P3245-LVE.
 - Interior multi sensor camera Axis P3717-PLE.

Attachments include 38 additional sheets and ends with drawing SK-04 dated 02/16/22.



02/16/2022

Δ3 SECTION 08 56 59 - HORIZONTAL TRANSACTION WINDOWS

PART 1 - GENERAL

1.1 RELATED DOCUMENTS

A. Drawings and general provisions of the Contract, including General and Supplementary Conditions and Division 01 Specification Sections, apply to this Section.

1.2 SUMMARY

- A. Section Includes:
 - Horizontal lift transaction windows.

1.3 COORDINATION

A. Coordinate installation of anchorages for transaction windows. Furnish setting drawings, templates, and directions for installing anchorages, including sleeves, concrete inserts, anchor bolts, and items with integral anchors, that are to be embedded in adjacent construction. Deliver such items to Project site in time for installation.

1.4 PREINSTALLATION MEETINGS

A. Preinstallation Conference: Conduct conference at Project site.

1.5 SUBMITTALS

- A. Product Data: For each type of product.
 - 1. Include construction details, material descriptions, dimensions of individual components and profiles, and finishes for window units.
- B. Shop Drawings: For transaction windows.
 - 1. Include plans, elevations, sections, and attachments to other work.
 - 2. Full-size section details of framing members, including internal armoring, reinforcement, and stiffeners.
 - 3. Location of weep holes.
 - 4. Hardware for sliding window units.
 - 5. Glazing details.
 - 6. Details of deal tray, transaction drawer, transaction counter and speaking aperture.
- C. Samples for Initial Selection: For frame members with factory-applied color finishes.
- Samples for Verification: For each type of exposed finish required, prepared on Samples of size indicated below:
 - 1. Framing: 12-inch- (305-mm-) long sections of frame members.
- E. Cutaway Sample: Corner of transaction window, made from 12-inch (305-mm) lengths of full-size components, and showing details of the following:
 - 1. Joinery.
 - 2. Anchorage.
 - Glazing.
 - 4. Flashing and drainage.

1.6 QUALITY ASSURANCE

- A. Installer Qualifications: An authorized representative who is trained and approved by manufacturer for installation and maintenance of units required for this Project.
- B. Welding Qualifications: Qualify procedures and personnel according to the following:
 - AWS D1.1/D1.1M, "Structural Welding Code Steel."
 - 2. AWS D1.2/D1.2M. "Structural Welding Code Aluminum."
 - 3. AWS D1.3, "Structural Welding Code Sheet Steel."
 - 4. AWS D1.6, "Structural Welding Code Stainless Steel."

1.7 DELIVERY, STORAGE, AND HANDLING

- A. Pack windows in wood crates for shipment. Crate glazing separate from frames unless factory glazed.
- B. Label transaction window packaging with drawing designation.
- C. Store crated transaction windows on raised blocks to prevent moisture damage.

1.8 FIELD CONDITIONS

A. Field Measurements: Verify actual dimensions of openings by field measurements before fabrication.

1.9 SEQUENCING

A. Field Painting: Except where transaction windows have been preglazed before installation, complete field painting of transaction windows before glazing installation.

1.10 WARRANTY

- A. Special Warranty: Manufacturer agrees to repair or replace transaction windows that fail in materials or workmanship within specified warranty period.
 - 1. Failures include, but are not limited to, the following:
 - a. Structural failures including deflections exceeding 1/4 inch (6 mm).
 - b. Failure of welds.
 - c. Excessive air leakage.
 - d. Faulty operation of sliding window hardware.
 - e. Faulty operation of transaction drawers.
 - f. Deterioration of metals, metal finishes, and other materials beyond normal weathering and use.
 - 2. Warranty Period: Five years from date of Substantial Completion.

PART 2 - PRODUCTS

2.1 HORIZONTAL LIFT TRANSACTION WINDOWS

- A. Configuration: Two glazed panels that slide horizontal and meet at center of transaction window.
- B. Framing: Fabricate perimeter framing, mullions, and glazing stops from steel, stainless steel, or aluminum as follows:
 - 1. Profile: Manufacturer's standard, with minimum face dimension indicated.

- a. Minimum Face Dimension: As indicated on Drawings.
- 2. Depth: As indicated on Drawings.
- 3. Provide thermally improved construction for aluminum framing.
- C. Head and Jamb Framing: Designed for sealant or gasket glazing.
- D. Glazing Meeting Edges: Polished glazing.
- E. Sill: Stainless-steel channel frame designed for sealant or gasket glazing.
 - 1. Shelf: Stainless steel, 2-3/4" inches deep by width of transaction window.
- F. Sliding Window Hardware: Provide roller track designed for overhead support of two- or four-wheel carriage supporting horizontal-sliding glazed panel. Provide manufacturer's standard pull and lock with two keys for each horizontal-sliding glazed panel.
 - 1. Provide weather stripping for exterior horizontal-sliding, transaction transaction windows.
- G. Glazing and Glazing Materials: Two (2) 1/4" tempered glass in a sealed insulated unit.
- H. Materials:
 - 1. Aluminum Extrusions: ASTM B 221 (ASTM B 221M). Provide alloy and temper recommended by manufacturer for strength, corrosion resistance, and application of required finish, but not less than 22,000-psi (150-MPa) ultimate tensile strength.
 - 2. Aluminum Sheet and Plate: ASTM B 209 (ASTM B 209M).

2.2 FABRICATION

- A. General: Fabricate transaction windows to provide a complete system for assembly of components and anchorage of window units.
 - 1. Provide units that are reglazable from the secure side without dismantling the nonsecure side of framing.
 - 2. Prepare transaction windows for glazing unless preglazing at the factory is indicated.
- B. Provide weep holes and internal water passages for exterior transaction windows to conduct infiltrating water to the exterior.
- C. Framing: Miter or cope corners the full depth of framing; weld and dress smooth.
 - 1. Fabricate framing with manufacturer's standard, internal opaque armoring in thicknesses required for transaction windows to comply with ballistics-resistance performance indicated.
- D. Glazing Stops: Finish glazing stops to match transaction window framing.
 - 1. Secure-Side (Exterior) Glazing Stops: Welded or integral to framing.
 - 2. Nonsecure-Side (Interior) Glazing Stops: Removable, coordinated with glazing indicated.
- E. Welding: Weld components to comply with referenced AWS standard. To greatest extent possible, weld before finishing and in concealed locations to minimize distortion or discoloration of finish. Remove weld spatter and welding oxides from exposed surfaces by descaling or grinding.
- F. Metal Protection: Separate dissimilar metals to protect against galvanic action by painting contact surfaces with primer or by applying sealant or tape recommended by manufacturer for this purpose.

- G. Factory-cut openings in glazing for speaking apertures.
- H. Preglazed Fabrication: Preglaze window units at factory, where required for applications indicated.
- I. Weather Stripping: Factory applied.

2.3 GENERAL FINISH REQUIREMENTS

- A. Comply with NAAMM/NOMMA 500 for recommendations for applying and designating finishes.
- B. Protect mechanical finishes on exposed surfaces from damage by applying a strippable, temporary protective covering before shipping.
- C. Appearance of Finished Work: Noticeable variations in same piece are not acceptable. Variations in appearance of adjoining components are acceptable if they are within the range of approved Samples and are assembled or installed to minimize contrast.

2.4 ALUMINUM FINISHES

A. Clear Anodic Finish: AAMA 611, AA-M12C22A41, Class I, 0.018 mm or thicker.

2.5 ACCESSORIES

- A. Anchors, Clips, and Window Accessories: Stainless steel; hot-dip, zinc-coated steel or iron, complying with ASTM B 633; provide sufficient strength to withstand design pressures indicated.
- B. Bituminous Paint: Cold-applied asphalt emulsion complying with ASTM D 1187.
- C. Sealants: For sealants required within fabricated transaction windows, provide type recommended by manufacturer for joint size and movement. Sealant shall remain permanently elastic, nonshrinking, and nonmigrating.

PART 3 - EXECUTION

3.1 EXAMINATION

- A. Examine substrates, areas, and conditions, with Installer present, for compliance with requirements for installation tolerances and other conditions affecting performance of transaction windows.
- B. Examine roughing-in for embedded and built-in anchors to verify actual locations of transaction window connections before transaction window installation.
- C. For the record, prepare written report, endorsed by Installer, listing conditions detrimental to performance of transaction windows.
- D. Inspect built-in and cast-in anchor installations, before installing transaction windows, to verify that anchor installations comply with requirements. Prepare inspection reports.
 - 1. Remove and replace anchors where inspections indicate that they do not comply with specified requirements. Reinspect after repairs or replacements are made.
 - 2. Perform additional inspections to determine compliance of replaced or additional work. Prepare anchor inspection reports.

- E. For glazing materials whose orientation is critical for performance, verify installation orientation.
- F. Proceed with installation only after unsatisfactory conditions have been corrected.

3.2 PREPARATION

- A. Coordination: Furnish layouts for cast-in-place anchors, clips, and other transaction window anchors whose installation is specified in other Sections.
 - 1. Furnish cast-in-place anchors and similar devices to other trades for installation well in advance of time needed for coordinating other work.

3.3 INSTALLATION

- A. Fastening to In-Place Construction: Provide anchorage devices and fasteners where necessary for securing transaction windows to in-place construction. Include threaded fasteners for inserts, transaction fasteners, and other connectors.
 - 1. Install an attached or integral flange to secure side of transaction windows extending over rough-in opening gap so that gap has same forced-entry-resistance and ballistics-resistance performance as transaction window.
- B. Glazed Framing: Provide sealant and gasket-glazed framing.
- C. Removable Glazing Stops and Trim: Fasten components with transaction fasteners.
- D. Fasteners: Install transaction windows using fasteners recommended by manufacturer with head style appropriate for installation requirements, strength, and finish of adjacent materials. Provide stainless-steel fasteners in stainless-steel materials.
- E. Sealants: Comply with requirements in Section 07 92 00 "Joint Sealants" for installing sealants, fillers, and gaskets.
 - Set continuous sill members and flashing in a full sealant bed to provide weathertight construction unless otherwise indicated.
 - 2. Seal frame perimeter with sealant to provide weathertight construction unless otherwise indicated.
- F. Metal Protection: Where dissimilar metals will contact each other, protect against galvanic action by painting contact surfaces with primer or by applying sealant or tape recommended in writing by manufacturer for this purpose. Where aluminum will contact concrete or masonry, protect against corrosion by painting contact surfaces with bituminous paint.

3.4 FIELD QUALITY CONTROL

- A. Inspect installed products to verify compliance with requirements. Prepare inspection reports and indicate compliance with and deviations from the Contract Documents.
- B. Perform additional inspections to determine compliance of replaced or additional Work. Prepare inspection reports.
- C. Prepare field quality-control certification that states installed products and their installation comply with requirements in the Contract Documents.

3.5 ADJUSTING

A. Adjust horizontal-sliding, transaction windows to provide a tight fit at contact points for smooth operation and a secure enclosure.

B. Remove and replace defective Work, including transaction windows that are warped, bowed, or otherwise unacceptable.


3.6 CLEANING AND PROTECTION


- A. Clean surfaces promptly after installation of transaction windows. Take care to avoid damaging the finish. Remove excess glazing and sealant compounds, dirt, and other substances.
 - 1. Lubricate sliding transaction window hardware.
 - 2. Lubricate transaction drawer hardware.
- B. Clean glass of preglazed transaction windows promptly after installation.
- C. Provide temporary protection to ensure that transaction windows are without damage at time of Substantial Completion.


3.7 DEMONSTRATION

A. Train Owner's maintenance personnel to adjust, operate, and maintain operable transaction windows.

END OF SECTION 08 56 59

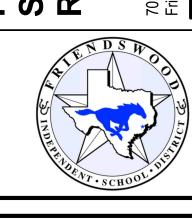

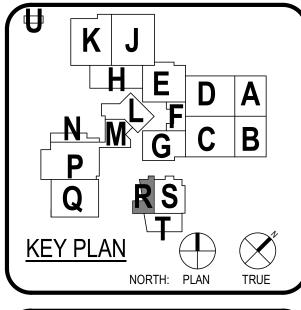

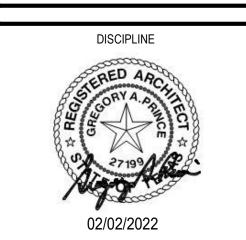

	FRIENDSV	VOOD IS	D
	ECT NUMBER 20381	02/	DATE 02/2022
		DRAWI	NG HISTORY
No.	Descript	ion	Date
3	ADDENDUM 03		02/16/2022
	ISSUE FOR	PROPOS	SAL SAL
		BUILDI	NG NUMBER

1ST FLOOR PLAN -SCHEDULES - AREA R1

A-101R1

							D	OOR	SCHE	:DULE	: AKE	AK				
	DATA			PAN	EL					FR.	ME					GENERAL
												DETAIL	-	H	ARDWARE	
MARK	ROOM NAME	WIDTH	HEIGHT	ELEVATION	THK	MATERIAL	FINISH	TYPE	MATERIAL	FINISH	SILL	JAMB	HEAD	FIRE RATING	SET	REMARKS
R100 CO	DRRIDOR	6'-0"	6'-10"	F	1 3/4"	SCPL	PLAM	001	HM	PAINTED	06/A-832	11/A-832	16/A-832		700M	
R100A PAG		6'-1 1/4"	6'-10 5/8"	HG-2	1 3/4"	AL	CLR ANOD	NONE	AL	CLR ANOD	03/A-831	08/A-831	13/A-831		CW714AM	
R100B PA		6'-1 1/4"	6'-8 5/8"	HG-2	1 3/4"	Al	CLR ANOD	NONE	Al	CLR ANOD	03/A-831	08/A-831	13/A-831		CW714AM	
	NCESSION	22'-6"	7'-6"	OHCG	1 3/4"	HM	HM	00HC	HM	HM	~~~~		~~~~	^~~~	~ ~ ~ ~ ~	^
,,,,,,,,,,,,,,,,,,,,,,,,,,,,,,,,,,,,,	ANO STORAGE	7'-0"	7'-0"	\ \ \ \ \ \ \ \ \ \ \ \ \ \ \ \ \ \ \ 	1 3/4"	SCPL	PLAM	001	HM	PAINTED	06/A-832	11/A-832	16/A-832	45MIN	212W	DOOR PANEL TO BE SOLID BLACK PLAM ON THE STAGE SIDE
R104A BLA		3'-0"	6'-10"	NV-1	1 3/4"	SCPL	PLAM	001	НМ	PAINTED	06/A-832	11/A-832	16/A-832		203	HEAVY-DUTY PERIMETER SEAL, DOOR PANEL TO BE SOLID BLACK PLAM ON THE STAGE SIDE
R104B BLA	ACK BOX	8'-0"	11'-10"	F	1 3/4"	SCPL	PLAM	001	НМ	PAINTED	06/A-832	11/A-832	16/A-832			HEAVY-DUTY PERIMETER SEAL, DOOR PANEL TO BE SOLID BLACK PLAM ON THE STAGE SIDE
R104C BLA	ACK BOX	6'-0"	6'-10"	F	1 3/4"	SCPL	PLAM	001	HM	PAINTED	06/A-832	11/A-832	16/A-832			HEAVY-DUTY PERIMETER SEAL, DOOR PANEL TO BE SOLID BLACK PLAM ON THE STAGE SIDE
R104D BLA	ACKBOX	6'-0"	6'-10"	F	1 3/4"	SCPL	PLAM	001	HM	PAINTED	06/A-832	11/A-832	16/A-832			HEAVY-DUTY PERIMETER SEAL, DOOR PANEL TO BE SOLID BLACK PLAM ON THE STAGE SIDE
R104E VES	STIBULE	6'-0"	6'-10"	F	1 3/4"	SCPL	PLAM	001	HM	PAINTED	06/A-832	11/A-832	16/A-832		700CM	HEAVY-DUTY PERIMETER SEAL
R104F VES	STIBULE	6'-0"	6'-10"	F	1 3/4"	SCPL	PLAM	001	HM	PAINTED	06/A-832	11/A-832	16/A-832		700CM	HEAVY-DUTY PERIMETER SEAL
R105 THI	EATER CLASSROOM	3'-0"	6'-10"	NV-1	1 3/4"	SCPL	PLAM	001	HM	PAINTED	06/A-832	11/A-832	16/A-832		203	HEAVY-DUTY PERIMETER SEAL
R106 OF	FICE	3'-0"	6'-10"	NV-1	1 3/4"	SCPL	PLAM	001	HM	PAINTED	06/A-832	11/A-832	16/A-832		103	
R107 BO	Y'S DRESSING	3'-0"	6'-10"	F	1 3/4"	SCPL	PAINTED	001	HM	PAINTED	06/A-832	11/A-832	16/A-832		801	
R108 ME	EN	3'-0"	6'-10"	F	1 3/4"	SCPL	PAINTED	001	HM	PAINTED	06/A-832	11/A-832	16/A-832		801	
R109 WC	OMEN	3'-0"	6'-10"	F	1 3/4"	SCPL	PAINTED	001	HM	PAINTED	06/A-832	11/A-832	16/A-832		801	

						WI	NDOW :	SCHED	ULE AREA R
		1	1	FRA	ME				
							DETAILS		
MARK	WIDTH	HEIGHT	ELEVATION	MATERIAL	FINISH	SILL	JAMB	HEAD	REMARKS
R106	8'-0"	4'-0"	A	HM	PAINTED	07/A-833	12/A-833	17/A-833	PROVIDE MINI-BLINDS; RE: SPECS

					RO	OOM FIN	VISH S	CHEDULE	E AREA R
	ROOM DATA					INISHES		CEILINGS	
Nº	NAME	FLOOR FINISH	BASE FINISH	NORTH	EAST	SOUTH	WEST	FINISH	COMMENTS
R100	CORRIDOR	CPT-1	RB-1	PT-6	PT-6	PT-6	PT-6	24"X24" ACT TYPE 1	
R100A	CONCESSION		RB-1						
R101E	PIANO STORAGE	SC-1	RB-1	PT-1	PT-1	PT-1	PT-1	24"X24" ACT TYPE 1	
R104	BLACK BOX	WF-1	RB-2	PT-6	PT-6	PT-6	PT-6	OPEN CEILING	
R104A	VEST	WF-1	RB-2						
R104B	VEST	WF-1	RB-2						
R104C	STOR.	WF-1	RB-2						
R105	THEATER CLASSROOM /	CPT-1	RB-1	PT-1	PT-1	PT-1	PT-1	24"X24" ACT TYPE 1	
	MAKERSPACE								
R106	OFFICE	CPT-1	RB-1	PT-1	PT-1	PT-1	PT-1	24"X24" ACT TYPE 1	
	BOY'S DRESSING	LVT-1	RB-1	SEE ELEV.	SEE ELEV.	SEE ELEV.	SEE ELEV.	PAINTED GYP. BD.	
	BOYS	PFT-1	WT-1	SEE ELEV.	SEE ELEV.	SEE ELEV.	SEE ELEV.	PAINTED GYP. BD.	
R109	GIRLS	PFT-1	WT-1	SEE ELEV.	SEE ELEV.	SEE ELEV.	SEE ELEV.	PAINTED GYP. BD.	

STOREFRONT SCHEDULE AREA R										
	FRA	ME					DETAILS			
MARK	WIDTH	HEIGHT	ELEVATION	MATERIAL	FINISH	SILL	HEAD	JAMB	REMARKS	
								_		
R100A	23'-10 1/2"	33'-3"	X	AL	CLR ANOD				EXTERIOR CURTAIN WALL W/ SECURITY FILM	
R100B	16'-7 3/8"	33'-3"	0	AL	CLR ANOD				EXTERIOR CURTAIN WALL W/ SECURITY FILM	
R100C	9'-0"	9'-8"	R	AL	CLR ANOD				EXTERIOR STOREFRONT W/ SECURITY FILM	
R100D	9'-0"	9'-8"	R	AL	CLR ANOD				EXTERIOR STOREFRONT W/ SECURITY FILM	
R100E	9'-0"	9'-8"	R	AL	CLR ANOD				EXTERIOR STOREFRONT W/ SECURITY FILM	
R100F	9'-0"	9'-8"	R	AL	CLR ANOD				EXTERIOR STOREFRONT W/ SECURITY FILM	
R102C	9'-0"	9'-8"	R	AL	CLR ANOD	02/A-831	12/A-831	07/A-831		
R102D	9'-0"	9'-8"	R	AL	CLR ANOD	02/A-831	12/A-831	07/A-831		
R102E	9'-0"	9'-8"	R	AL	CLR ANOD	02/A-831	12/A-831	07/A-831		
R102F	9'-0"	9'-8"	R	AL	CLR ANOD	02/A-831	12/A-831	07/A-831		

CHECKED BY:
Checker
DRAWN BY:
Author
Plot Stamp:
2/16/2022 2:26:49 PM

AREA R

AREA T

RD.9

. DO NOT SCALE DRAWINGS, WRITTEN DIMENSIONS TAKE PRECEDENCE, CONTACT ARCH IF CLARIFICATION IS NECESSARY IN ORDER TO DETERMINE THE INTENT OF THE CONTRACT

. ALL DIMENSIONS ARE TO STRUCTURAL COLUMN LINES OR THE SURFACE OF PARTITION ASSEMBLY

4. FIELD VERIFY ALL DIMENSIONS AND EXISTING CONDITIONS BEFORE COMMENCING WORK. NOTIFY

ARCH. OF ANY DISCREPANCIES PRIOR TO PROCEEDING WITH AFFECTED WORK . NOTES OR DIMENSIONS NOTED AS "TYPICAL" OR "TYP." OR "TYP" SHALL APPLY TO CONDITIONS THAT

. DIMENSIONS NOTED AS "FIELD VERIFY" OR "V.I.F." OR "VIF" SHALL BE MEASURED AND CONFIRMED AT THE PROJECT SITE BY THE CONTRACTOR AND REVIEWED WITH THE ARCH. BEFORE INCORPORATING

. DIMENSIONS NOTED AS "CLEAR" OR "CLEAR INSIDE" REQUIRE SPECIFIC COORDINATION AMONG

9. ALL INTERIOR PARTITIONS THIS SHEET, EXCEPT FOR FURR-OUT PARTITIONS, SHALL BE PARTITION

10. ALL INTERIOR FURR-OUT PARTITIONS THIS SHEET SHALL BE PARTITION TYPE M2B U.N.O.

11. ALIGN FINISHED FACE OF WALLS WHERE WALL PARTITIONS OF DIFFERING THICKNESS ABUT AND OR

14. ALL DOORS SHALL BE SET 6 INCHES OFF THE ADJACENT PERPENDICULAR WALL ON THE HINGE SIDE

OF THE DOOR U.N.O., NOTIFY ARCH. OF ANY DOOR-RELATED CONFLICTS, INCLUDING BUT NOT

16. COORD. ALL ROOF DRAIN LEADER LOCATIONS WITH FLOOR PLAN PRIOR TO FLOOR SLAB

18. PROVIDE AND INSTALL SELF-LEVELING UNDERLAYMENT WHERE UNEVEN FLOOR SLAB EXISTS PRIOR


19. COORD. HOUSEKEEPING PAD LOCATIONS AND DIMENSIONS WITH EQUIPMENT TO BE INSTALLED 20. ALL FLOOR FINISH CHANGES SHALL OCCUR AT THE CENTERLINE OF DOORS U.N.O.


22. ALL REQUIRED ACCESSIBLE CLEARANCES FOR ALL ITEMS, INCLUDING BUT NOT LIMITED TO ALL COUNTER TOPS, ALL PLUMBING FIXTURES, ALL DRINKING FOUNTAINS, ALL ELECTRIC WATER


6'-0" x 6'-0" CEILING MOUNTED PROJECTION SCREEN U.N.O.; RE: SPECS

HOUSTON 11 Greenway Plaza, 22nd Floor Houston, TX 77046 713-965-0608 P 713-961-4571 F TX Firm: BR 1608

FRIENDSWOOD HIGH SCHOOL ADDITIONS AND RENOVATIONS

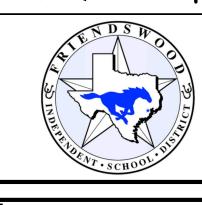

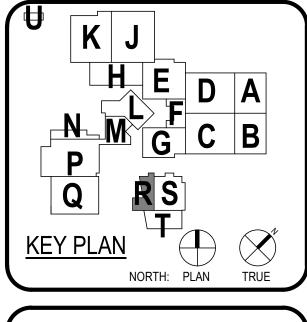

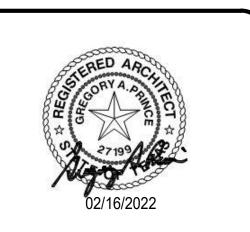

	CL	IENT	
	FRIENDSV	VOOD ISD	
	DATE 02/02/2022		CT NUMBER 20381
DF	RAWING HISTORY		
No.	Descript	tion	Date
3	ADDENDUM 03		02/16/2022
	ISSUE FOR	PROPOSAL	
		·	

1ST FLOOR PLAN AREA R

A-101R

CHECKED BY: Checker DRAWN BY: Plot Stamp: 2/16/2022 10:12:24 PM

05 1ST FLOOR PLAN AREA R

GENERAL ARCH PLAN NOTES

- . DO NOT SCALE DRAWINGS, WRITTEN DIMENSIONS TAKE PRECEDENCE, CONTACT ARCH IF CLARIFICATION IS NECESSARY IN ORDER TO DETERMINE THE INTENT OF THE CONTRACT
- DRAWINGS NOTED AS "N.T.S" OR "NTS" ARE NOT TO SCALE . ALL DIMENSIONS ARE TO STRUCTURAL COLUMN LINES OR THE SURFACE OF PARTITION ASSEMBLY
- . FIELD VERIFY ALL DIMENSIONS AND EXISTING CONDITIONS BEFORE COMMENCING WORK. NOTIFY
- ARCH. OF ANY DISCREPANCIES PRIOR TO PROCEEDING WITH AFFECTED WORK . NOTES OR DIMENSIONS NOTED AS "TYPICAL" OR "TYP." OR "TYP" SHALL APPLY TO CONDITIONS THAT ARE THE SAME OR SIMILAR
- . DIMENSIONS NOTED AS "FIELD VERIFY" OR "V.I.F." OR "VIF" SHALL BE MEASURED AND CONFIRMED AT THE PROJECT SITE BY THE CONTRACTOR AND REVIEWED WITH THE ARCH. BEFORE INCORPORATING
- DIMENSIONS NOTED AS "CLEAR" OR "CLEAR INSIDE" REQUIRE SPECIFIC COORDINATION AMONG DISCIPLINES AND OR MANUFACTURERS
- . REFER TO PARTITION TYPES ON A-800 SERIES SHEETS
- . ALL INTERIOR PARTITIONS THIS SHEET, EXCEPT FOR FURR-OUT PARTITIONS, SHALL BE PARTITION
- 10. ALL INTERIOR FURR-OUT PARTITIONS THIS SHEET SHALL BE PARTITION TYPE M2B U.N.O. 11. ALIGN FINISHED FACE OF WALLS WHERE WALL PARTITIONS OF DIFFERING THICKNESS ABUT AND OR
- 12. PROVIDE AND INSTALL CONT. REVEAL TRIM AT JOINT WHERE GYPSUM BOARD WALL PARTITIONS ABUT AND OR ADJOIN MASONRY WALL PARTITIONS IN THE SAME PLANE 13. ALL INTERIOR CMU OUTSIDE CORNERS SHALL HAVE BULLNOSE U.N.O.
- 14. ALL DOORS SHALL BE SET 6 INCHES OFF THE ADJACENT PERPENDICULAR WALL ON THE HINGE SIDE OF THE DOOR U.N.O., NOTIFY ARCH. OF ANY DOOR-RELATED CONFLICTS, INCLUDING BUT NOT
- LIMITED TO CONFLICTS CONCERNING ACCESSIBILITY STANDARDS 15. ALL DOOR THRESHOLDS AT ALL EXTERIOR DOORS SHALL BE SET IN FULL BED OF SEALANT 16. COORD. ALL ROOF DRAIN LEADER LOCATIONS WITH FLOOR PLAN PRIOR TO FLOOR SLAB
- 17. ALL FLOOR SLOPES TO FLOOR DRAINS SHALL NOT EXCEED 1:48
- 18. PROVIDE AND INSTALL SELF-LEVELING UNDERLAYMENT WHERE UNEVEN FLOOR SLAB EXISTS PRIOR TO INSTALLATION OF FLOOR FINISHES
- 19. COORD. HOUSEKEEPING PAD LOCATIONS AND DIMENSIONS WITH EQUIPMENT TO BE INSTALLED 20. ALL FLOOR FINISH CHANGES SHALL OCCUR AT THE CENTERLINE OF DOORS U.N.O.
- 21. ALL FLOOR FINISH MATERIAL CHANGES SHALL HAVE REDUCER STRIPS 22. ALL REQUIRED ACCESSIBLE CLEARANCES FOR ALL ITEMS, INCLUDING BUT NOT LIMITED TO ALL COUNTER TOPS, ALL PLUMBING FIXTURES, ALL DRINKING FOUNTAINS, ALL ELECTRIC WATER
- COOLERS, ALL LAVATORIES, ALL URINALS, ALL TOILETS SHALL BE STRICTLY ENFORCED 23. APPLY BITUMINOUS COATING TO ALL CONCEALED STRUCTURAL STEEL MEMBERS AT ALL EXTERIOR CANOPY LOCATIONS
- 24. REFER TO OTHER DISCIPLINE DOCUMENTS FOR ADDITIONAL SCOPE OF WORK


KEYNOTE LEGEND


DESCRIPTION


_1027 ____CORNER GUARDS ; RE: SPECS 1109 INDUSTRIAL METAL SHELVING; RE: SPECS

HOUSTON 11 Greenway Plaza, 22nd Floor Houston, TX 77046 713-965-0608 P 713-961-4571 F TX Firm: BR 1608

FRIENDSWOOD HIGH SCHOOL ADDITIONS AND RENOVATIONS

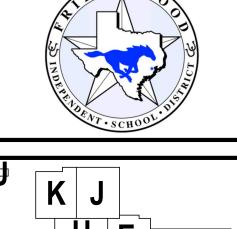

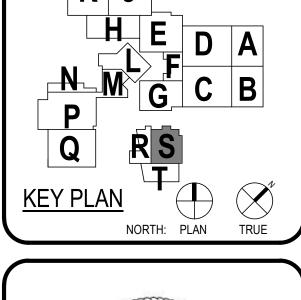

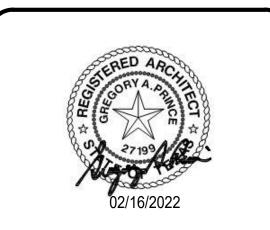


	CL FRIENDS\	IENT VOOD ISD	
	DATE 02/02/2022		CT NUMBE 0381
DI	RAWING HISTORY		
No.	Descrip	tion	Date
3	ADDENDUM 03		02/16/2022
	ISSUE FOR	DDODOSAI	
	1330E FOR	PROPUSAL	

1ST FLOOR PLAN AREA S

A-101S

CHECKED BY: Checker DRAWN BY: Author Plot Stamp: 2/16/2022 10:12:29 PM

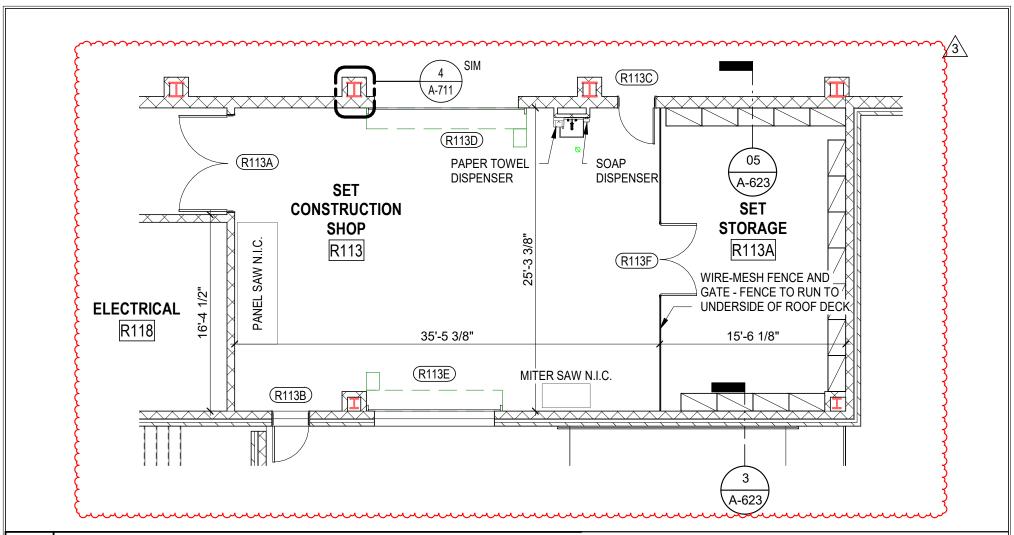

1ST FLOOR PLAN AREA T - SET SHOP 1/8" = 1'-0"



HOUSTON 11 Greenway Plaza, 22nd Floor Houston, TX 77046 713-965-0608 P 713-961-4571 F TX Firm: F-1608

PROJECT:

FRIENDSWOOD HIGH SCHOOL ADDITIONS AND **RENOVATIONS**

CURRENT REVISION DESCRIPTION: ADDENDUM 03

SCALE: DRW BY:

CHK BY:

1/8" = 1'-0"

Author

Checker

PROJECT No:

20381

RFI No:

REF SHEET:


2/16/2022 10:18:25 PM

SKETCH NUMBER:

SK-01



02/16/2022

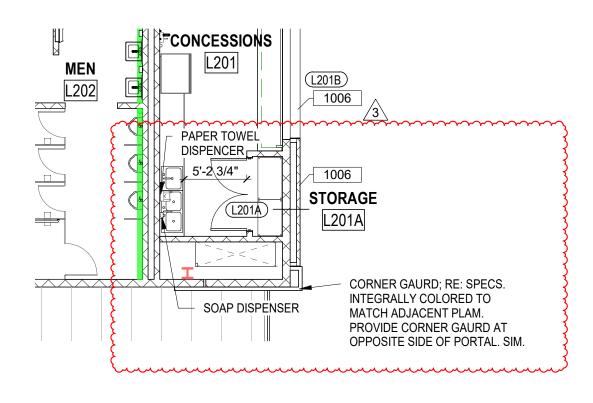

2ND FLOOR PLAN AREA Q - CONCESSIONS 1/8" = 1'-0"

HOUSTON 11 Greenway Plaza, 22nd Floor Houston, TX 77046 713-965-0608 P 713-961-4571 F TX Firm: F-1608

PROJECT:

FRIENDSWOOD HIGH SCHOOL ADDITIONS AND **RENOVATIONS**

CURRENT REVISION DESCRIPTION: ADDENDUM 03

SCALE: DRW BY: CHK BY:

1/8" = 1'-0" Author Checker **PROJECT No:**

20381

RFI No:

REF SHEET:


2/16/2022 10:18:58 PM

SKETCH NUMBER:

SK-02



02/16/2022

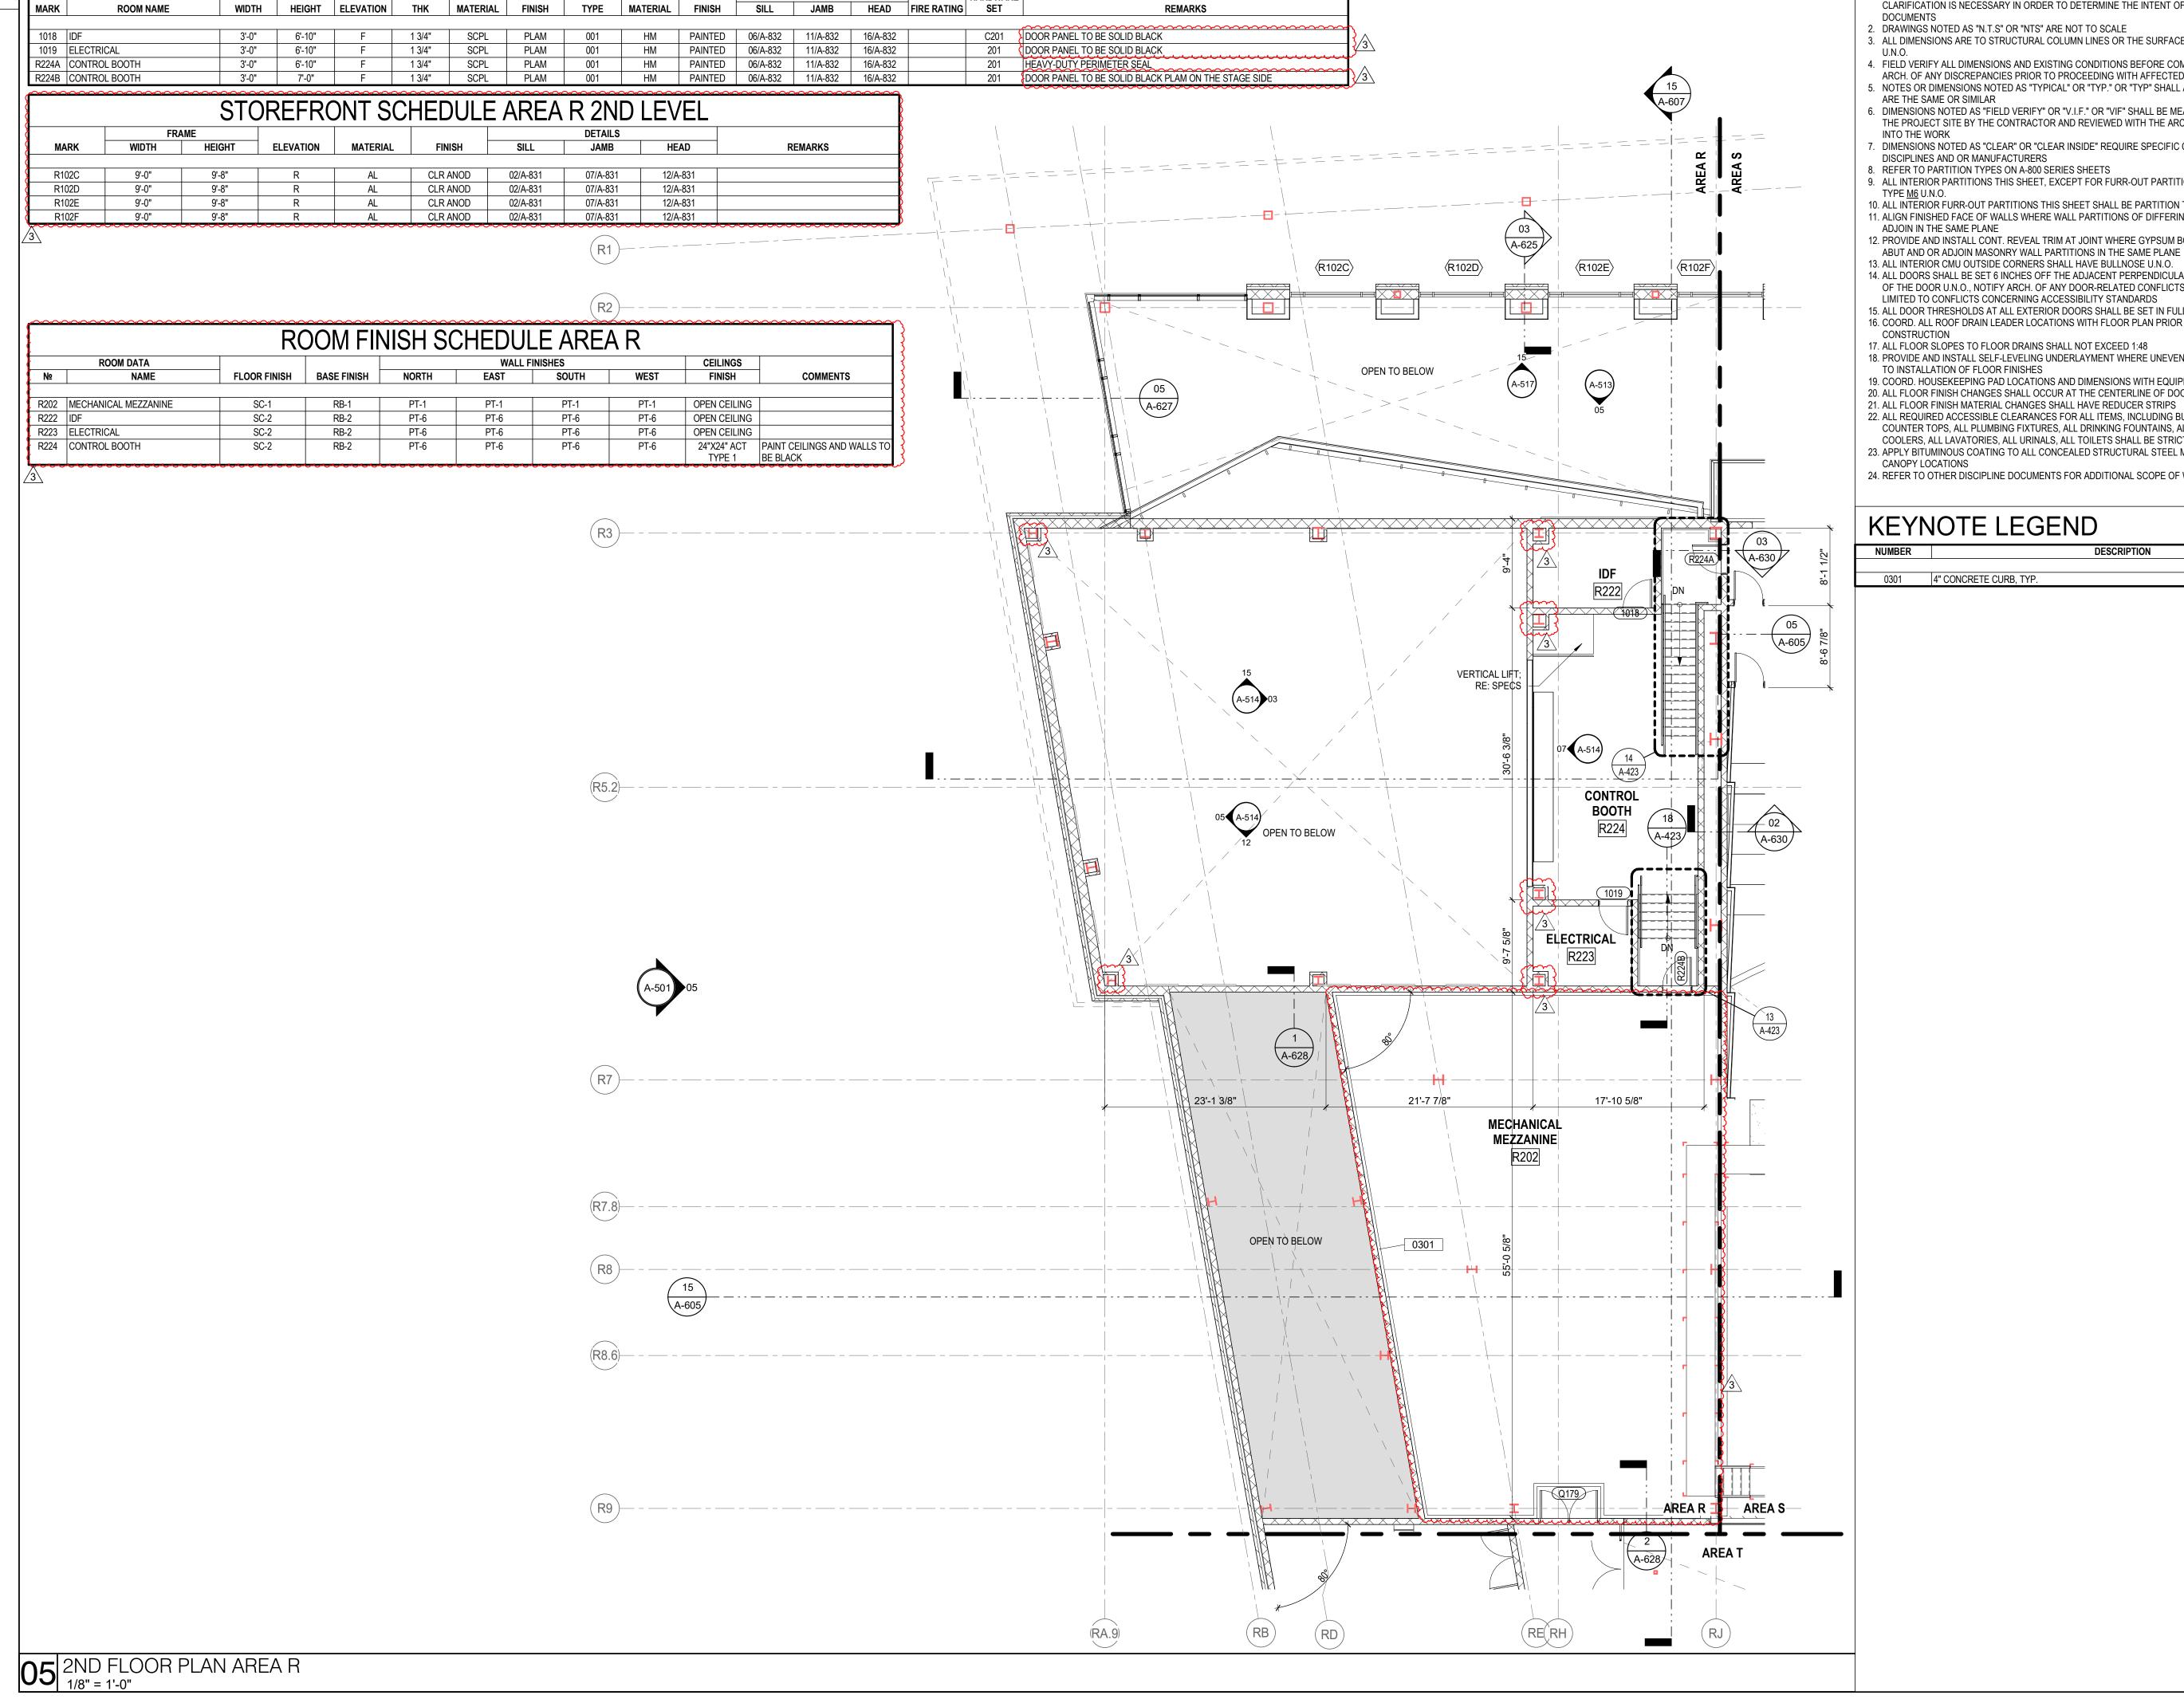

GENERAL

DOOR SCHEDULE AREA R

GENERAL ARCH PLAN NOTES

- . DO NOT SCALE DRAWINGS, WRITTEN DIMENSIONS TAKE PRECEDENCE, CONTACT ARCH IF CLARIFICATION IS NECESSARY IN ORDER TO DETERMINE THE INTENT OF THE CONTRACT
- 2. DRAWINGS NOTED AS "N.T.S" OR "NTS" ARE NOT TO SCALE
 3. ALL DIMENSIONS ARE TO STRUCTURAL COLUMN LINES OR THE SURFACE OF PARTITION ASSEMBLY
- . FIELD VERIFY ALL DIMENSIONS AND EXISTING CONDITIONS BEFORE COMMENCING WORK. NOTIFY ARCH. OF ANY DISCREPANCIES PRIOR TO PROCEEDING WITH AFFECTED WORK
- . NOTES OR DIMENSIONS NOTED AS "TYPICAL" OR "TYP." OR "TYP" SHALL APPLY TO CONDITIONS THAT . DIMENSIONS NOTED AS "FIELD VERIFY" OR "V.I.F." OR "VIF" SHALL BE MEASURED AND CONFIRMED AT
- THE PROJECT SITE BY THE CONTRACTOR AND REVIEWED WITH THE ARCH. BEFORE INCORPORATING
- DISCIPLINES AND OR MANUFACTURERS REFER TO PARTITION TYPES ON A-800 SERIES SHEETS
- 9. ALL INTERIOR PARTITIONS THIS SHEET, EXCEPT FOR FURR-OUT PARTITIONS, SHALL BE PARTITION
- 10. ALL INTERIOR FURR-OUT PARTITIONS THIS SHEET SHALL BE PARTITION TYPE M2B U.N.O.
- 11. ALIGN FINISHED FACE OF WALLS WHERE WALL PARTITIONS OF DIFFERING THICKNESS ABUT AND OR ADJOIN IN THE SAME PLANE 12. PROVIDE AND INSTALL CONT. REVEAL TRIM AT JOINT WHERE GYPSUM BOARD WALL PARTITIONS
- 13. ALL INTERIOR CMU OUTSIDE CORNERS SHALL HAVE BULLNOSE U.N.O. 14. ALL DOORS SHALL BE SET 6 INCHES OFF THE ADJACENT PERPENDICULAR WALL ON THE HINGE SIDE
- OF THE DOOR U.N.O., NOTIFY ARCH. OF ANY DOOR-RELATED CONFLICTS, INCLUDING BUT NOT LIMITED TO CONFLICTS CONCERNING ACCESSIBILITY STANDARDS
- 15. ALL DOOR THRESHOLDS AT ALL EXTERIOR DOORS SHALL BE SET IN FULL BED OF SEALANT 16. COORD. ALL ROOF DRAIN LEADER LOCATIONS WITH FLOOR PLAN PRIOR TO FLOOR SLAB
- 17. ALL FLOOR SLOPES TO FLOOR DRAINS SHALL NOT EXCEED 1:48 18. PROVIDE AND INSTALL SELF-LEVELING UNDERLAYMENT WHERE UNEVEN FLOOR SLAB EXISTS PRIOR
- TO INSTALLATION OF FLOOR FINISHES 19. COORD. HOUSEKEEPING PAD LOCATIONS AND DIMENSIONS WITH EQUIPMENT TO BE INSTALLED
- 20. ALL FLOOR FINISH CHANGES SHALL OCCUR AT THE CENTERLINE OF DOORS U.N.O. 21. ALL FLOOR FINISH MATERIAL CHANGES SHALL HAVE REDUCER STRIPS 22. ALL REQUIRED ACCESSIBLE CLEARANCES FOR ALL ITEMS, INCLUDING BUT NOT LIMITED TO ALL
- COUNTER TOPS, ALL PLUMBING FIXTURES, ALL DRINKING FOUNTAINS, ALL ELECTRIC WATER COOLERS, ALL LAVATORIES, ALL URINALS, ALL TOILETS SHALL BE STRICTLY ENFORCED 23. APPLY BITUMINOUS COATING TO ALL CONCEALED STRUCTURAL STEEL MEMBERS AT ALL EXTERIOR
- **CANOPY LOCATIONS** 24. REFER TO OTHER DISCIPLINE DOCUMENTS FOR ADDITIONAL SCOPE OF WORK

KEYNOTE LEGEND

NUMBER DESCRIPTION 0301 4" CONCRETE CURB, TYP.

FRIENDSWOOD HIGH SCHOOL ADDITIONS AND RENOVATIONS

HOUSTON


11 Greenway Plaza, 22nd Floor


Houston, TX 77046

713-965-0608 P

713-961-4571 F

TX Firm: BR 1608

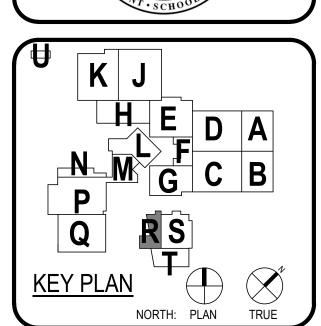


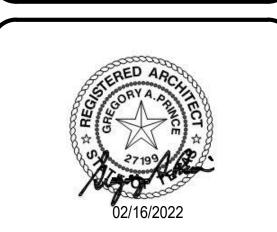

	-	IENT						
	FRIENDSV	vood ISD						
	DATE PROJEC 02/02/2022 20							
DF	RAWING HISTORY							
No.	Descrip	tion	Date					
3	ADDENDUM 03		02/16/2022					
	ISSUE FOR	PROPOSAL						

2ND FLOOR PLAN -**AREA** R

CHECKED BY: Checker DRAWN BY: Plot Stamp: 2/16/2022 10:12:38 PM

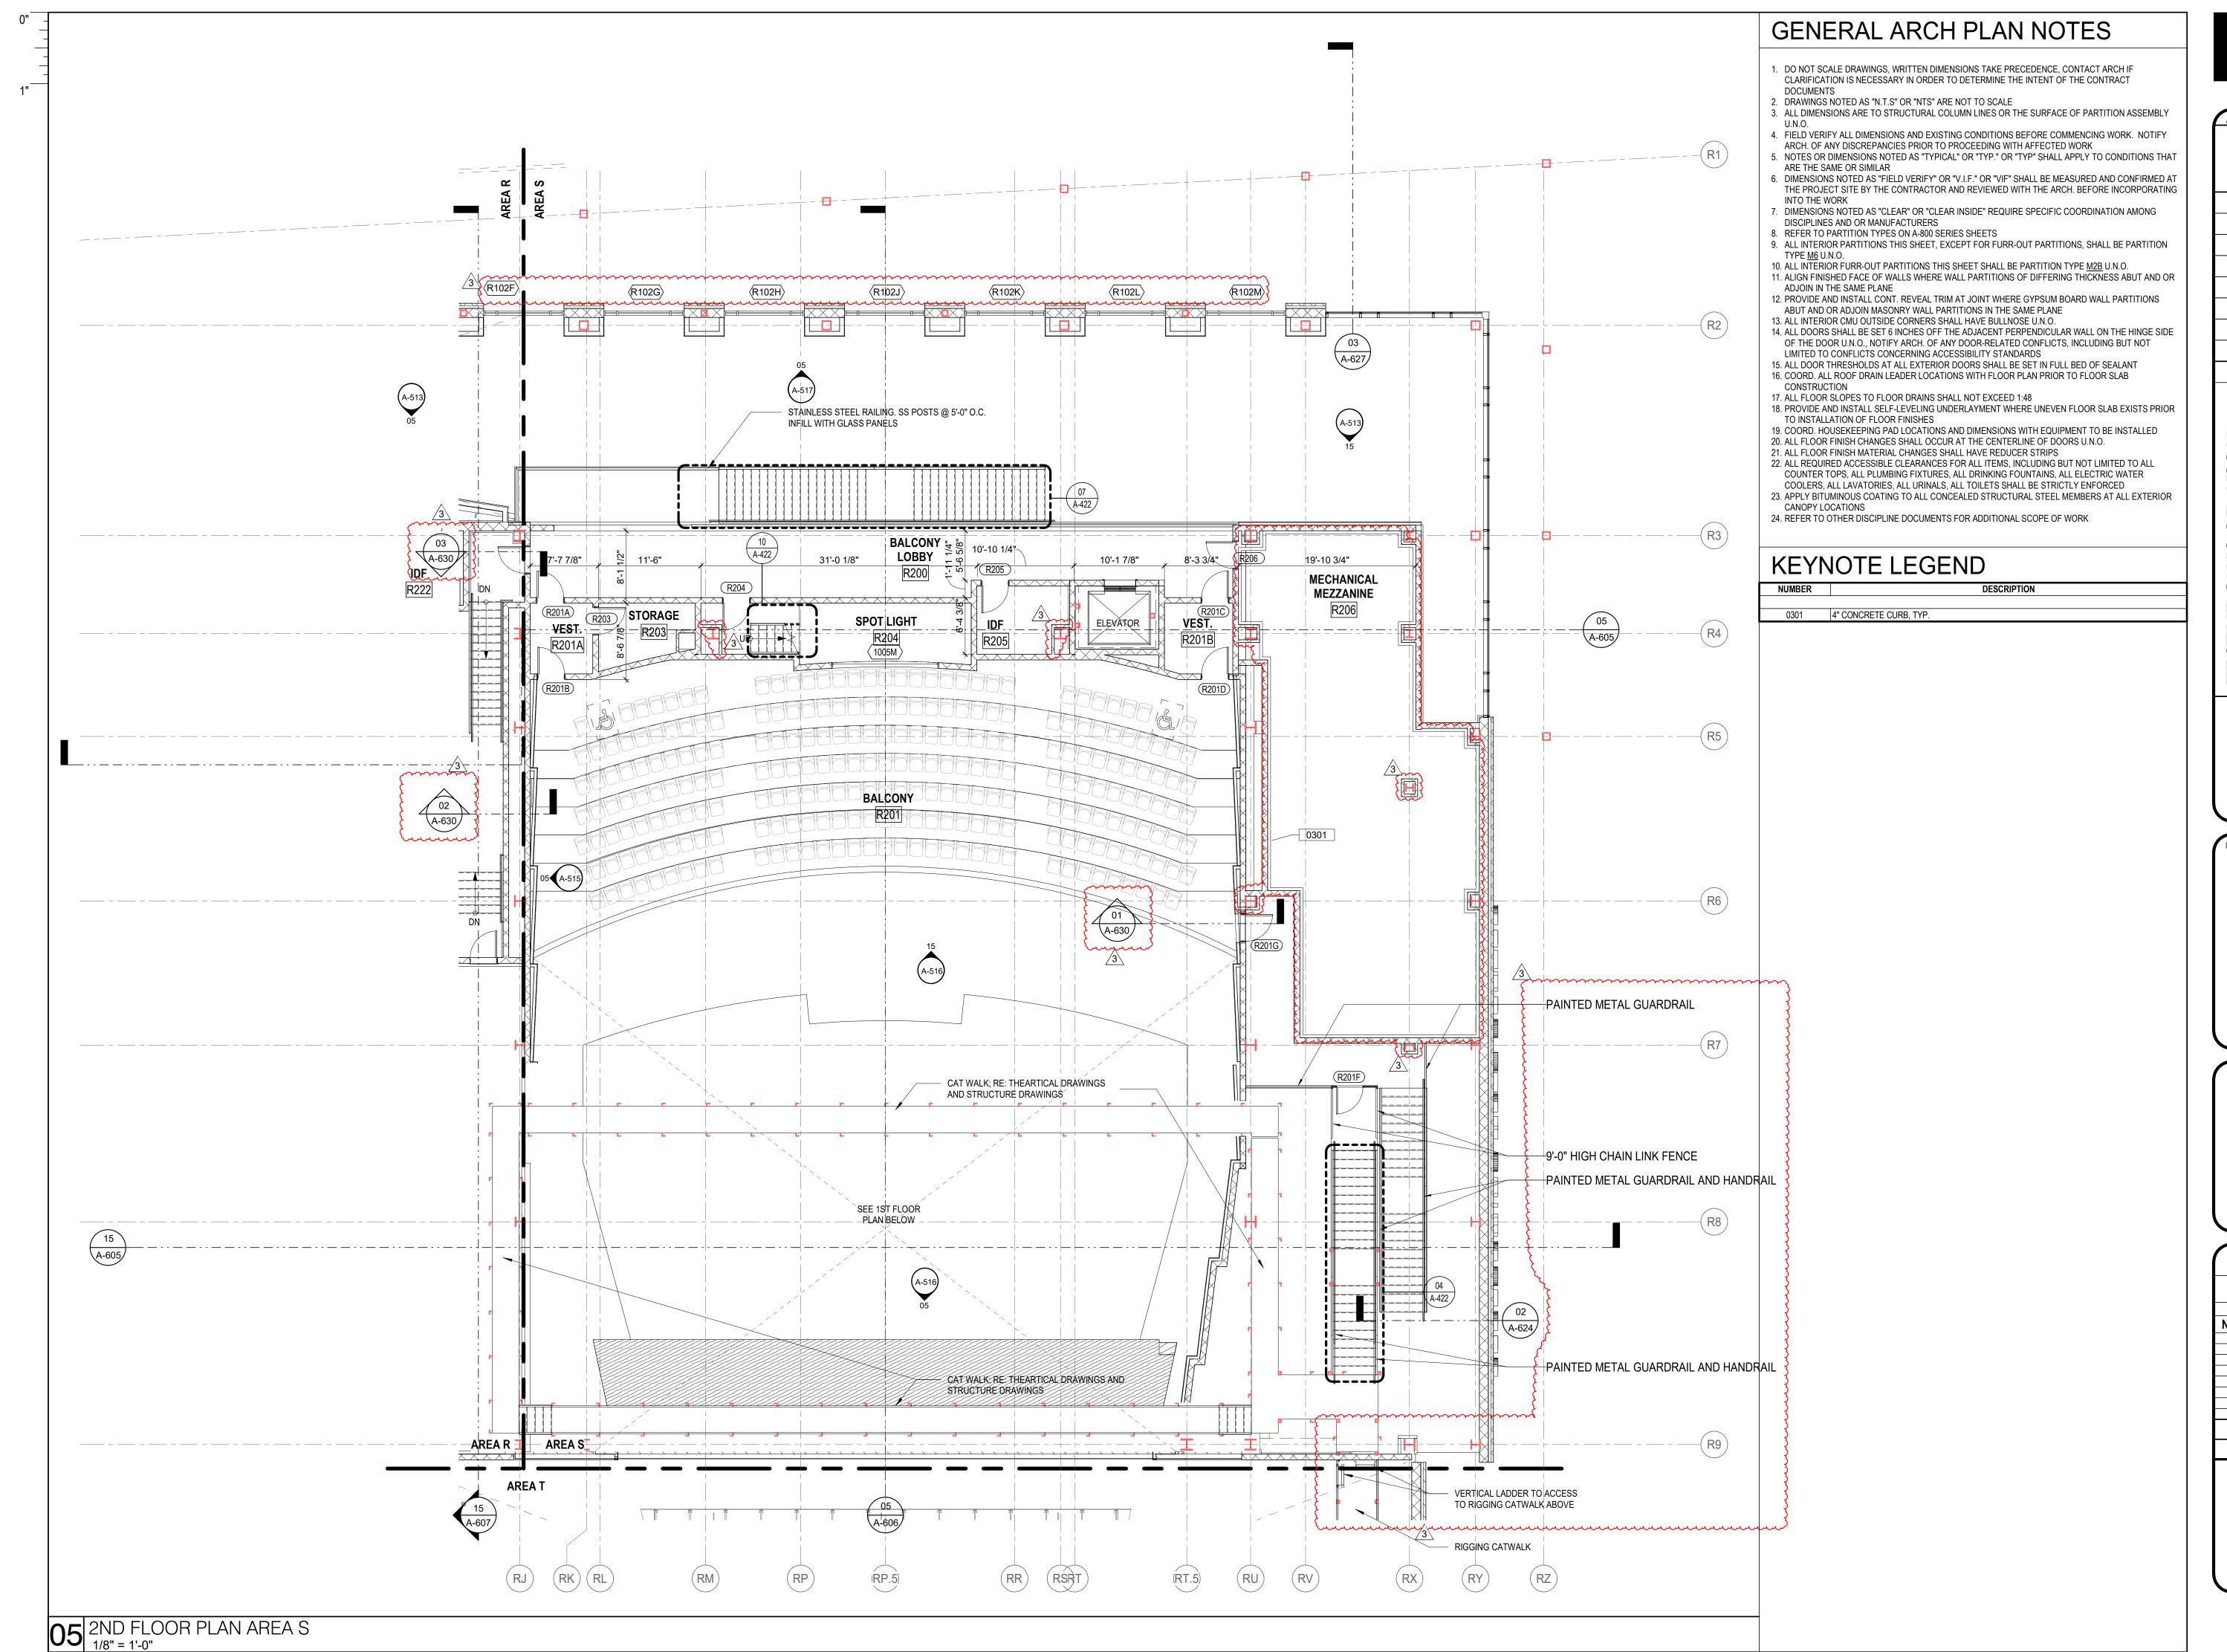



HITECT

HOUSTON

11 Greenway Plaza, 22nd Floor

Houston, TX 77046

713-965-0608 P

713-961-4571 F

TX Firm: BR 1608

CIVIL

DIG

T713-965-0608

SPORTS

PBK SPORTS

T 281-528-1697

LANDSCAPE

EDGELAND

T713-965-0608

STRUCTURAL

KUBALA ENGINEERS

T 800-248-3674

MEPT

LEAF ENGINEERS

T 713-940-3300

ENVELOPE

BEAM

T 713-940-3201

AV / ACOUSTIC


JAFFE HOLDEN


T 713-807-7100

THEATRICAL

SCHULER SHOOK

FRIENDSWOOD HIGH SCHOOL ADDITIONS AND RENOVATIONS

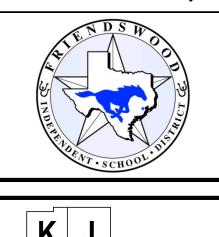

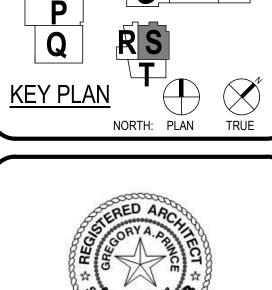


	01	IENIE	
	FRIENDSV	IENT VOOD ISD	`
			OT 111 MDED
	DATE 02/02/2022		CT NUMBER 0381
DR	RAWING HISTORY		
No.	Descript	tion	Date
3	ADDENDUM 03		02/16/2022
	ISSUE FOR	PROPOSAL	1

2ND FLOOR PLAN -AREA S

A-102S


GENERAL CEILING PLAN NOTES

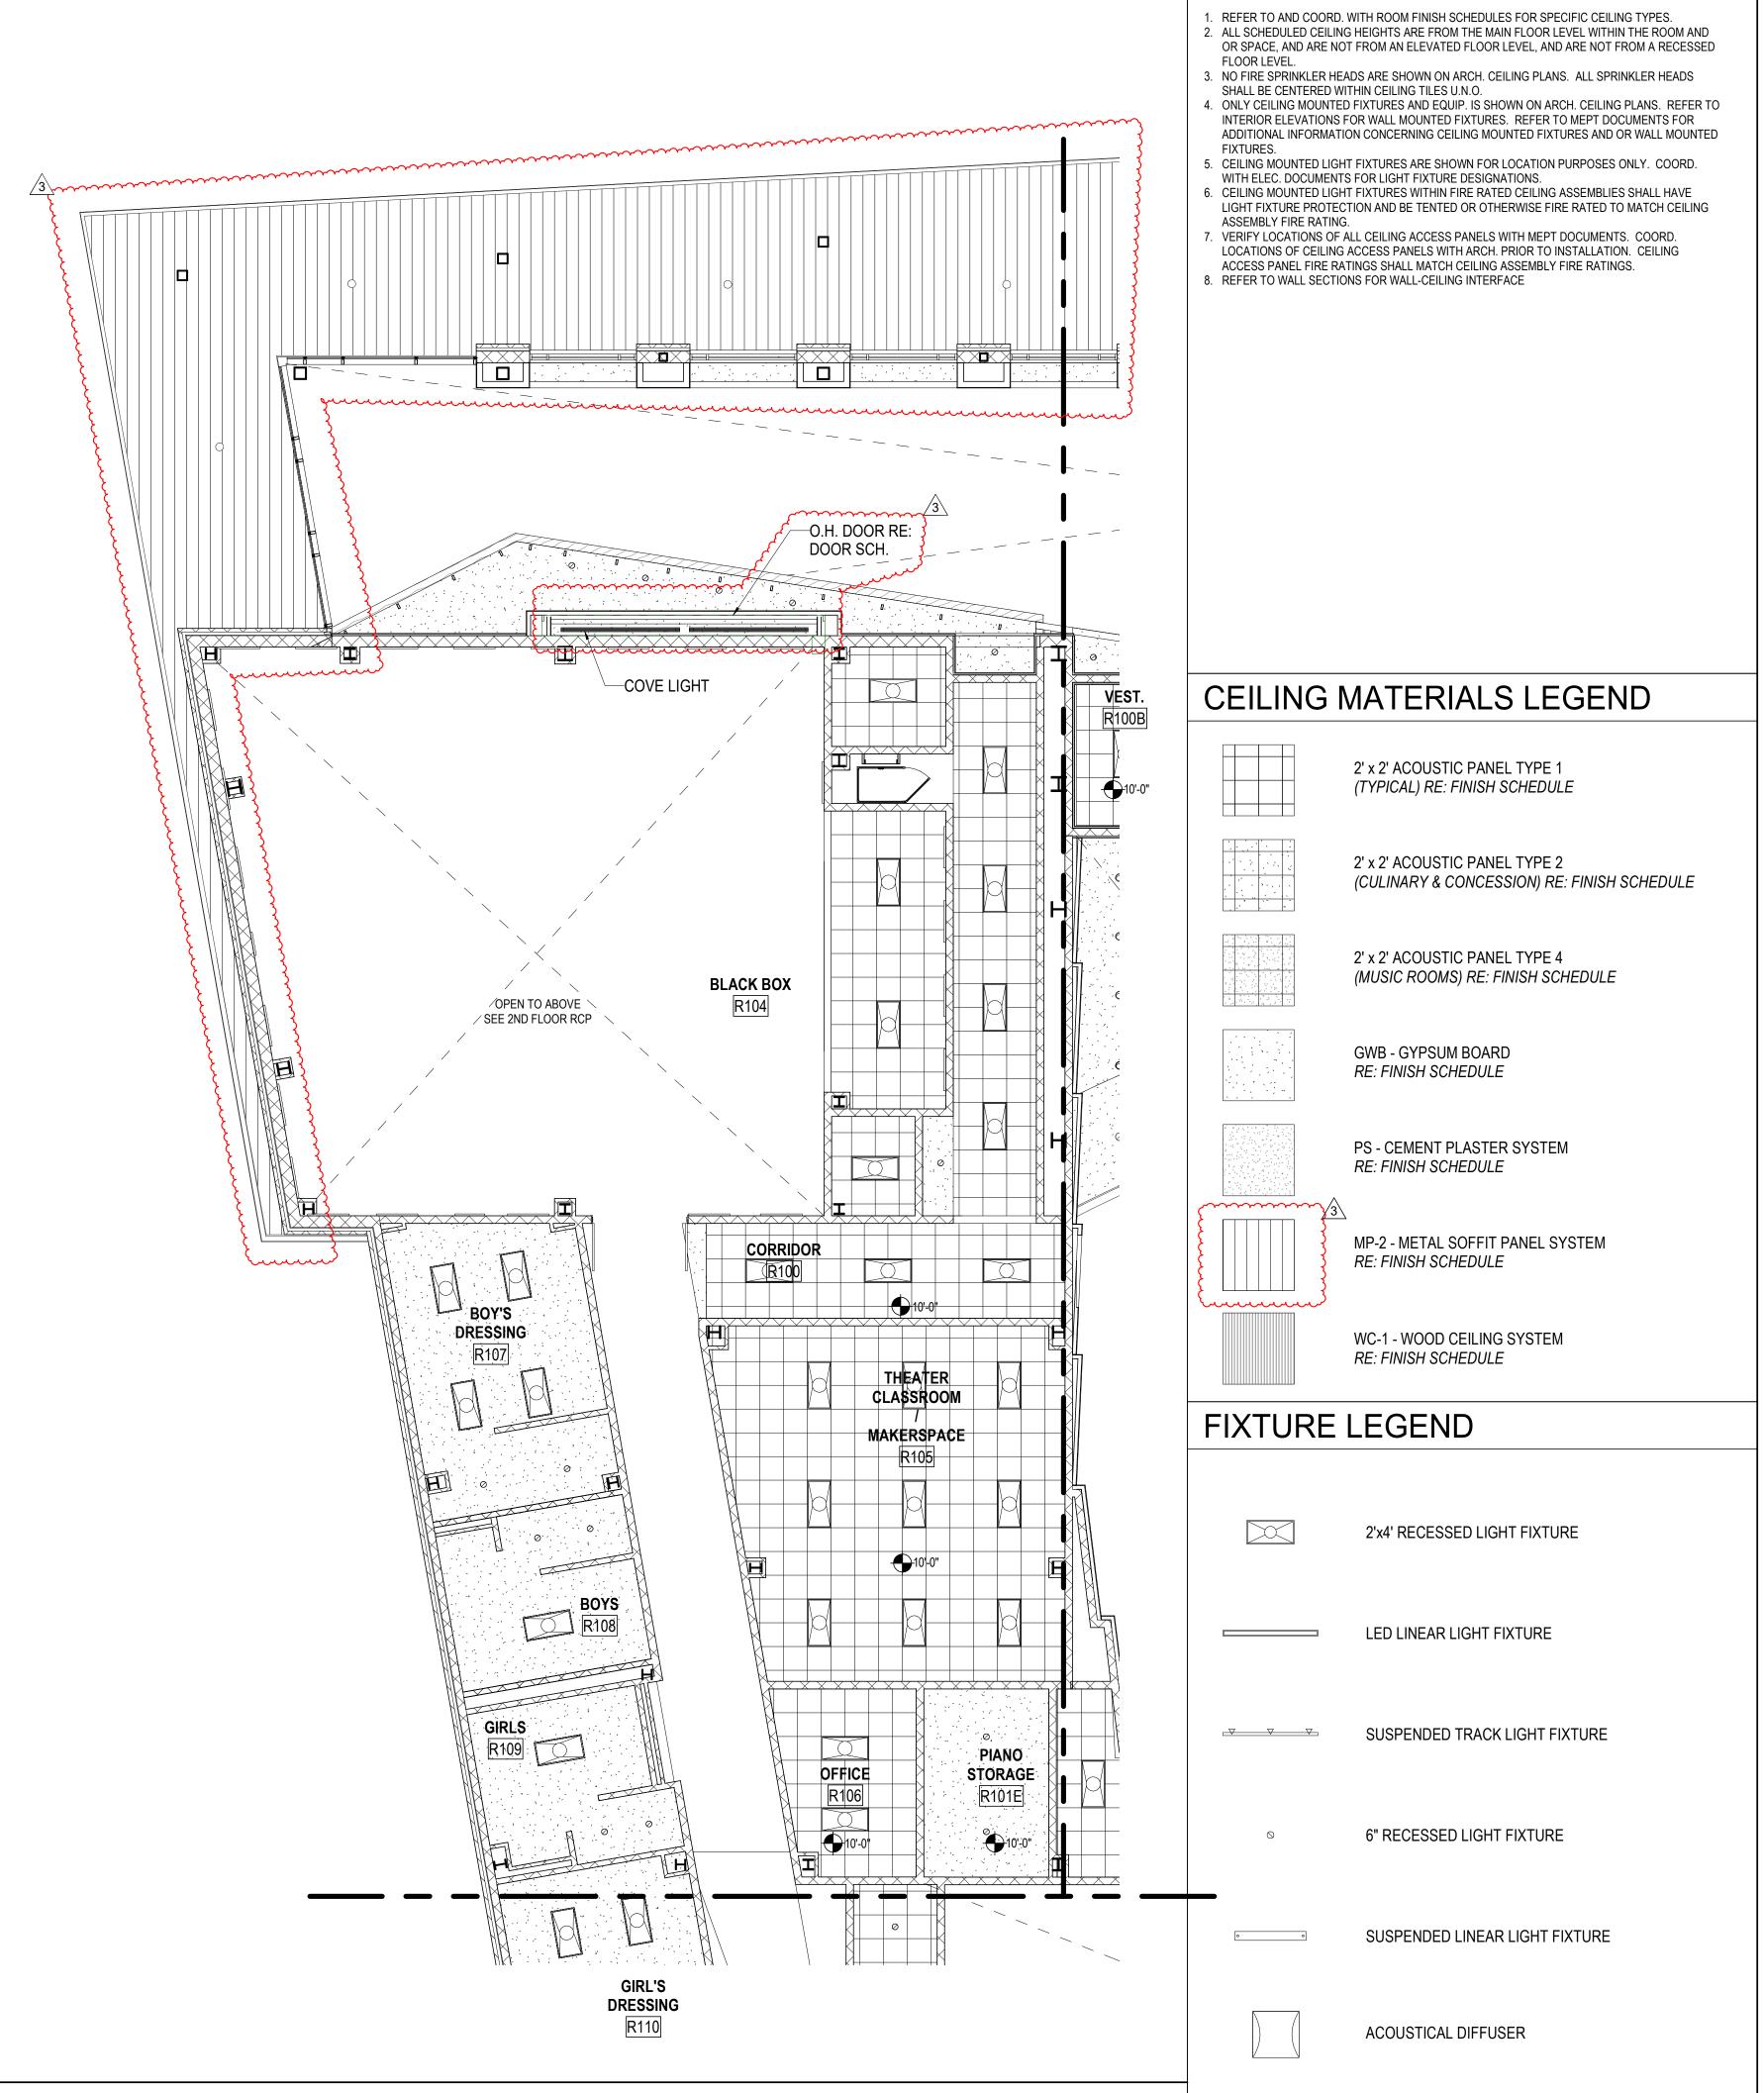





HOUSTON 11 Greenway Plaza, 22nd Floor Houston, TX 77046 713-965-0608 P 713-961-4571 F TX Firm: BR 1608

FOOD SERVICE FOOD DESIGN PROFESSIONALS FRIENDSWOOD HIGH SCHOOL ADDITIONS AND RENOVATIONS

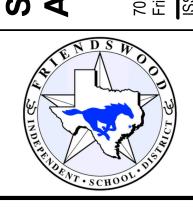

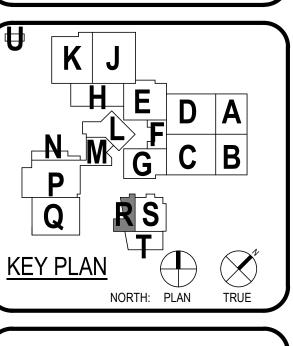

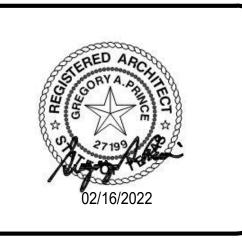

		IENT	
	FRIENDSV	VOOD ISD	
	DATE 02/02/2022		CT NUMBER 0381
DR	AWING HISTORY		
No.	Descrip	tion	Date
3	ADDENDUM 03		02/16/2022
	ISSUE FOR	PROPOSAL	

1ST FLOOR RCP -

AREA R

05 1ST FLOOR RCP - AREA R



RCHITECT PBK Architects,

HOUSTON PBK

11 Greenway Plaza, 22nd Floor
Houston, TX 77046

713-965-0608 P
713-961-4571 F
TX Firm: BR 1608

CIVIL
DIG
T713-965-0608

SPORTS
PBK SPORTS
PBK SPORTS
T 281-528-1697

LANDSCAPE
EDGELAND
T713-965-0608

STRUCTURAL
KUBALA ENGINEERS
T 800-248-3674

MEPT
LEAF ENGINEERS
T 713-940-3300

ENVELOPE
BEAM
T 713-940-3300

ENVELOPE
BEAM
T 713-940-3201


AV / ACOUSTIC
JAFFE HOLDEN
T 713-807-7100


THEATRICAL
SCHULER SHOOK
T 214-747-8300

FOOD SERVICE
FOOD DESIGN PROFESSIONALS

FRIENDSWOOD HIGH SCHOOL ADDITIONS AND RENOVATIONS



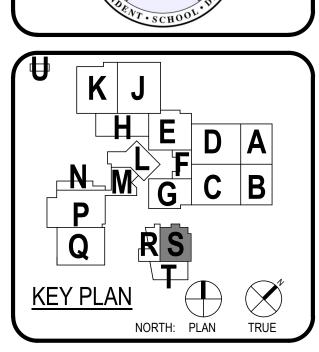

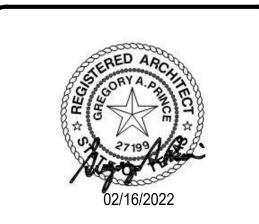


·	,	FRIENDSV		
No. Description Da				-
•	DF	RAWING HISTORY		
3 ADDENDUM 03 02/16/20	No.	Descrip	tion	Date
	3	ADDENDUM 03		02/16/2022
ISSUE FOR PROPOSAL		ISSUE FOR	PROPOSAL	ı

1ST FLOOR RCP -AREA S

Δ-201S

CHECKED BY:
Checker
DRAWN BY:
Author
Plot Stamp:
2/16/2022 10:12:02 PM

05 1ST FLOOR RCP - AREA S

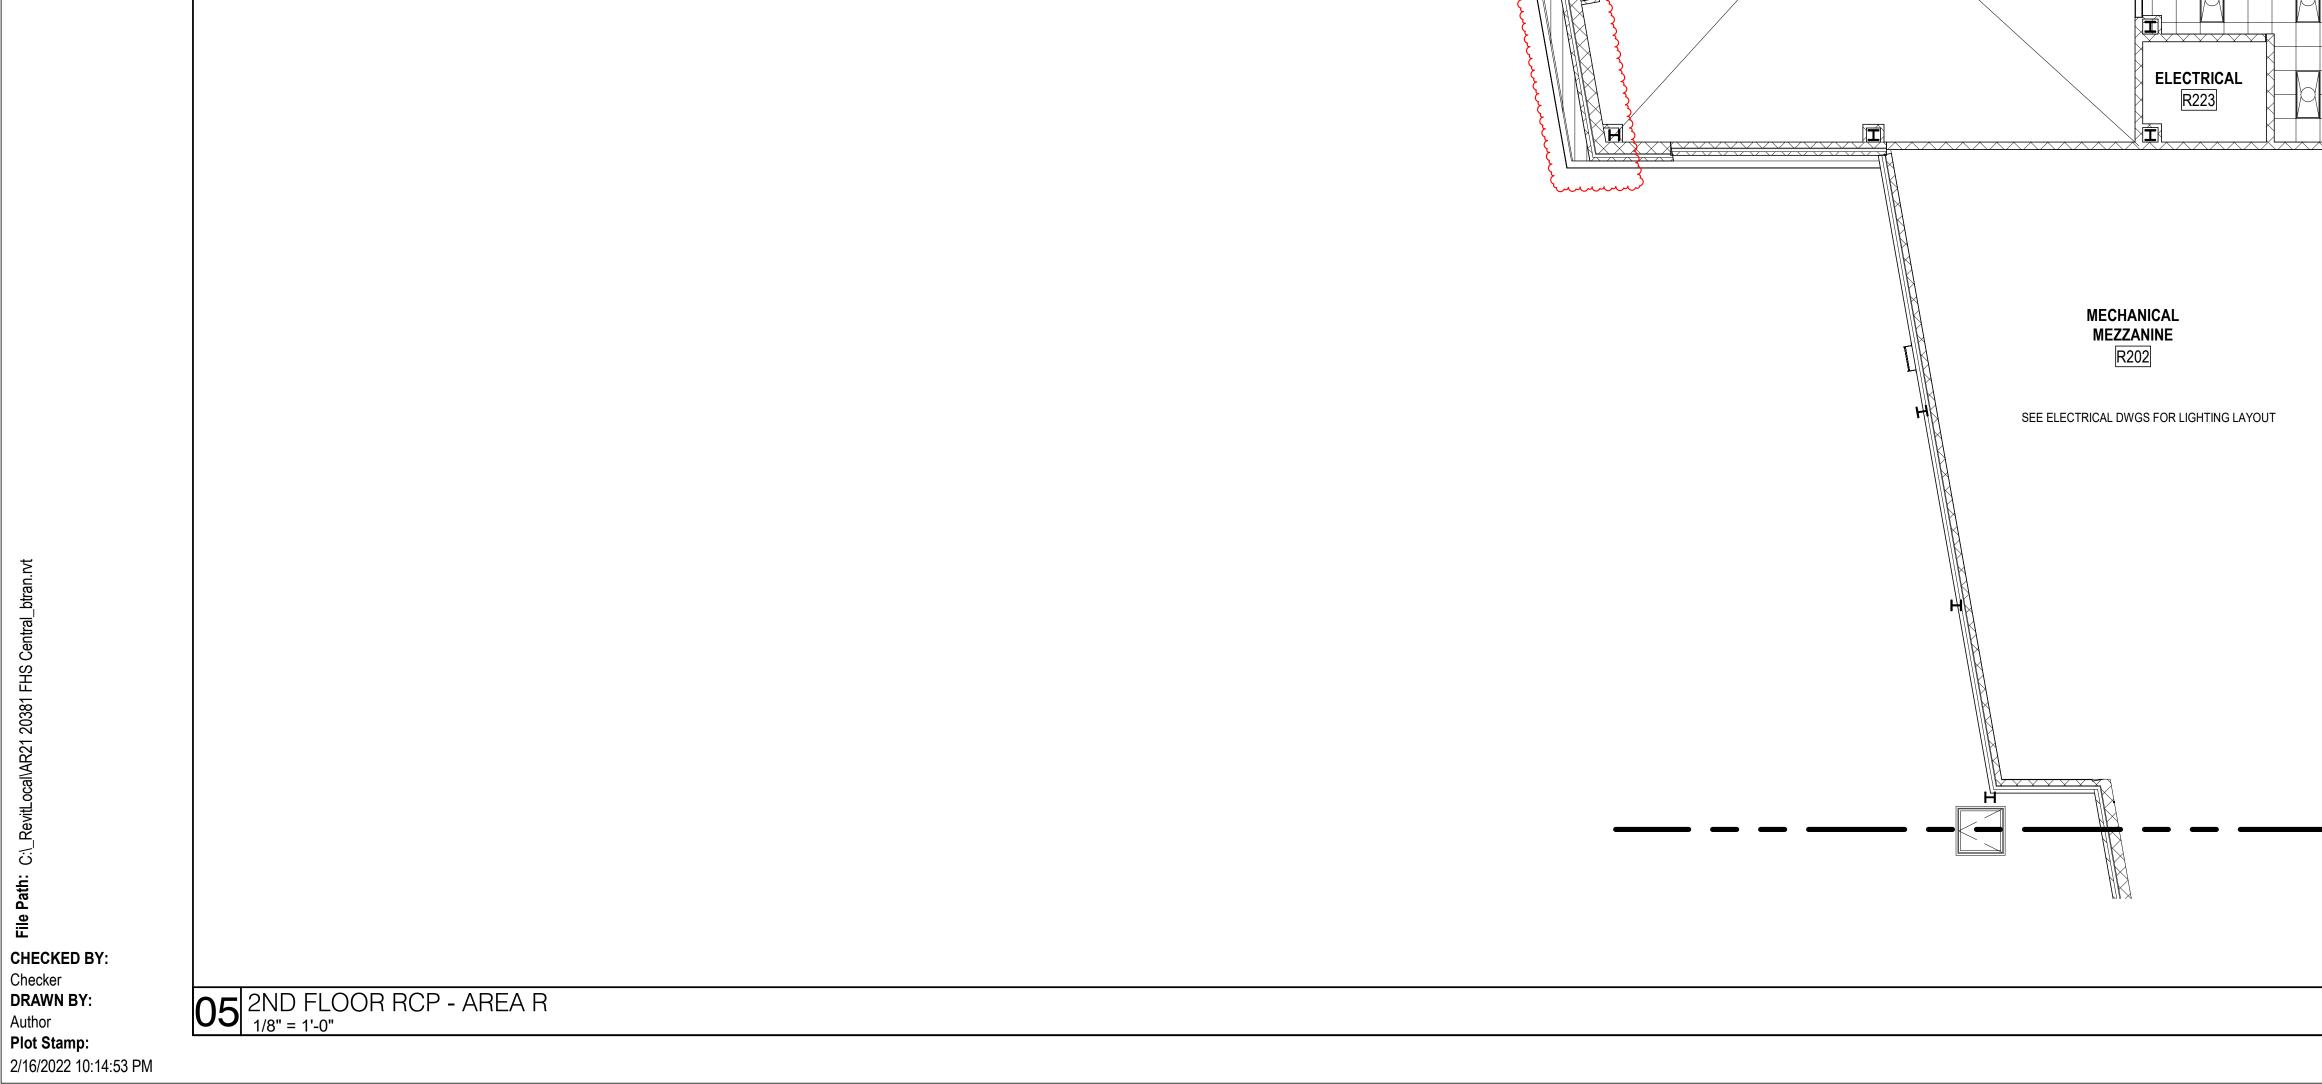

GENERAL CEILING PLAN NOTES . REFER TO AND COORD. WITH ROOM FINISH SCHEDULES FOR SPECIFIC CEILING TYPES. ALL SCHEDULED CEILING HEIGHTS ARE FROM THE MAIN FLOOR LEVEL WITHIN THE ROOM AND OR SPACE, AND ARE NOT FROM AN ELEVATED FLOOR LEVEL, AND ARE NOT FROM A RECESSED


LED LINEAR LIGHT FIXTURE


SUSPENDED TRACK LIGHT FIXTURE


SUSPENDED LINEAR LIGHT FIXTURE

6" RECESSED LIGHT FIXTURE

ACOUSTICAL DIFFUSER

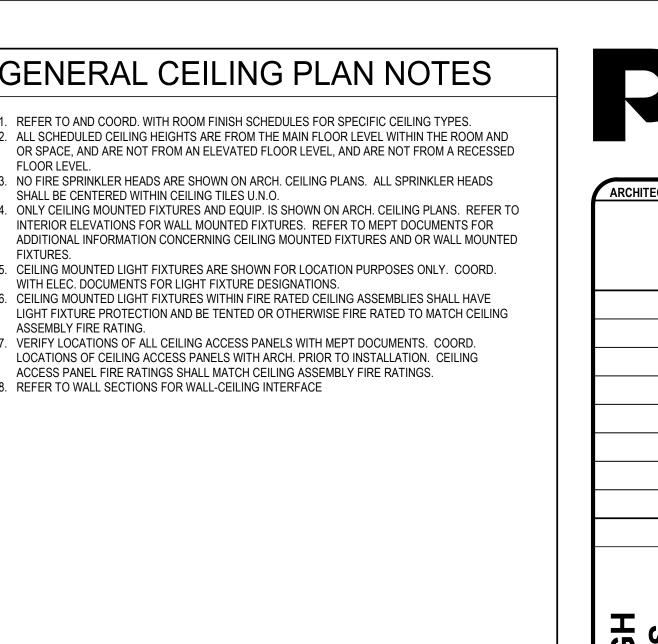

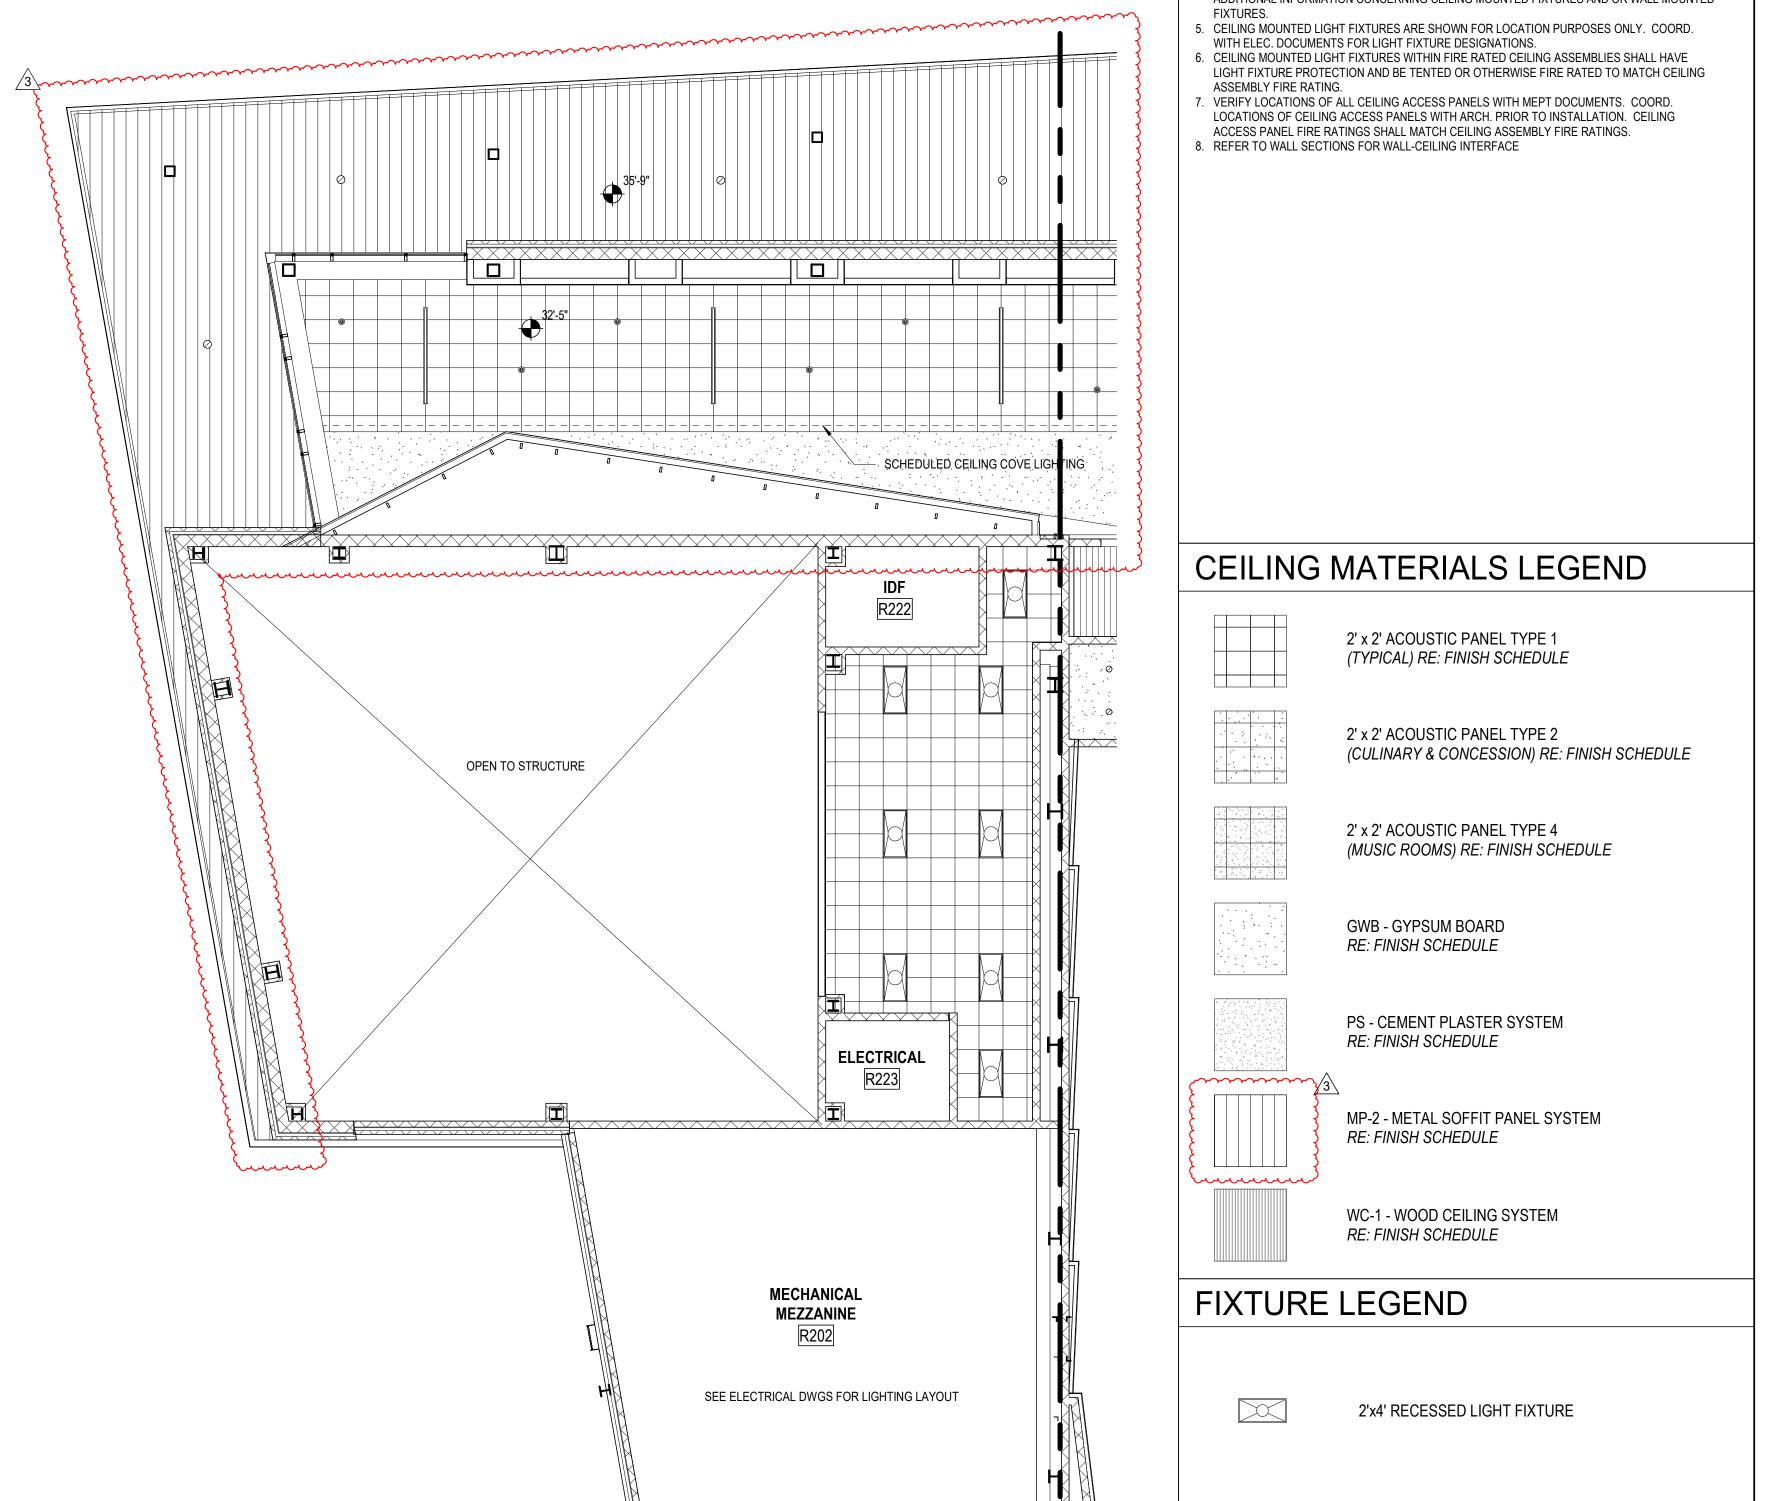

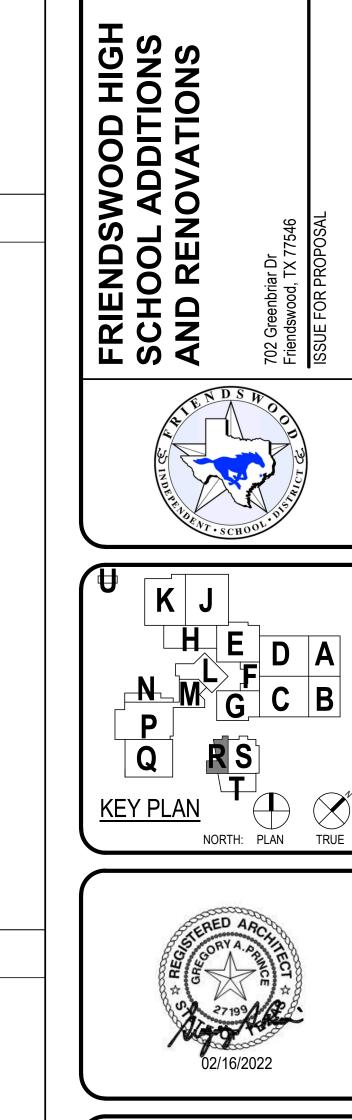

HOUSTON 11 Greenway Plaza, 22nd Floor

Houston, TX 77046

713-965-0608 P

713-961-4571 F

TX Firm: BR 1608

7	CL	ILIN I	
	FRIENDSV	VOOD ISD	
	DATE	PROJE	CT NUMBE
	02/02/2022	2	0381
DI	RAWING HISTORY		
No.	Descrip	tion	Date
3	ADDENDUM 03		02/16/2022
	ISSUE FOR	PROPOSAL	

2ND FLOOR RCP -**AREA R**


GENERAL CEILING PLAN NOTES


. REFER TO AND COORD. WITH ROOM FINISH SCHEDULES FOR SPECIFIC CEILING TYPES. ALL SCHEDULED CEILING HEIGHTS ARE FROM THE MAIN FLOOR LEVEL WITHIN THE ROOM AND OR SPACE, AND ARE NOT FROM AN ELEVATED FLOOR LEVEL, AND ARE NOT FROM A RECESSED

NO FIRE SPRINKLER HEADS ARE SHOWN ON ARCH. CEILING PLANS. ALL SPRINKLER HEADS

HOUSTON 11 Greenway Plaza, 22nd Floor Houston, TX 77046 713-965-0608 P 713-961-4571 F TX Firm: BR 1608

FRIENDSWOOD HIGH SCHOOL ADDITIONS AND RENOVATIONS

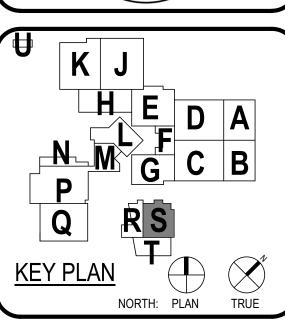

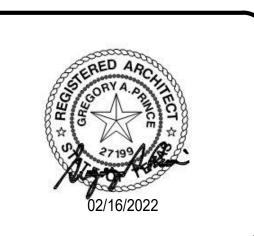


	CLIENT				
	FRIENDSV	VOOD ISD			
	DATE		CT NUMBER		
	02/02/2022	2	20381		
DF	RAWING HISTORY				
No.	Descrip	tion	Date		
3	ADDENDUM 03		02/16/2022		
	IOOUE FOR	DDODOOAL			
ISSUE FOR PROPOSAL					

2ND FLOOR RCP -**AREAS**

05 2ND FLOOR RCP - AREA S

CHECKED BY: Checker **DRAWN BY:** Author Plot Stamp: 2/16/2022 10:56:32 AM

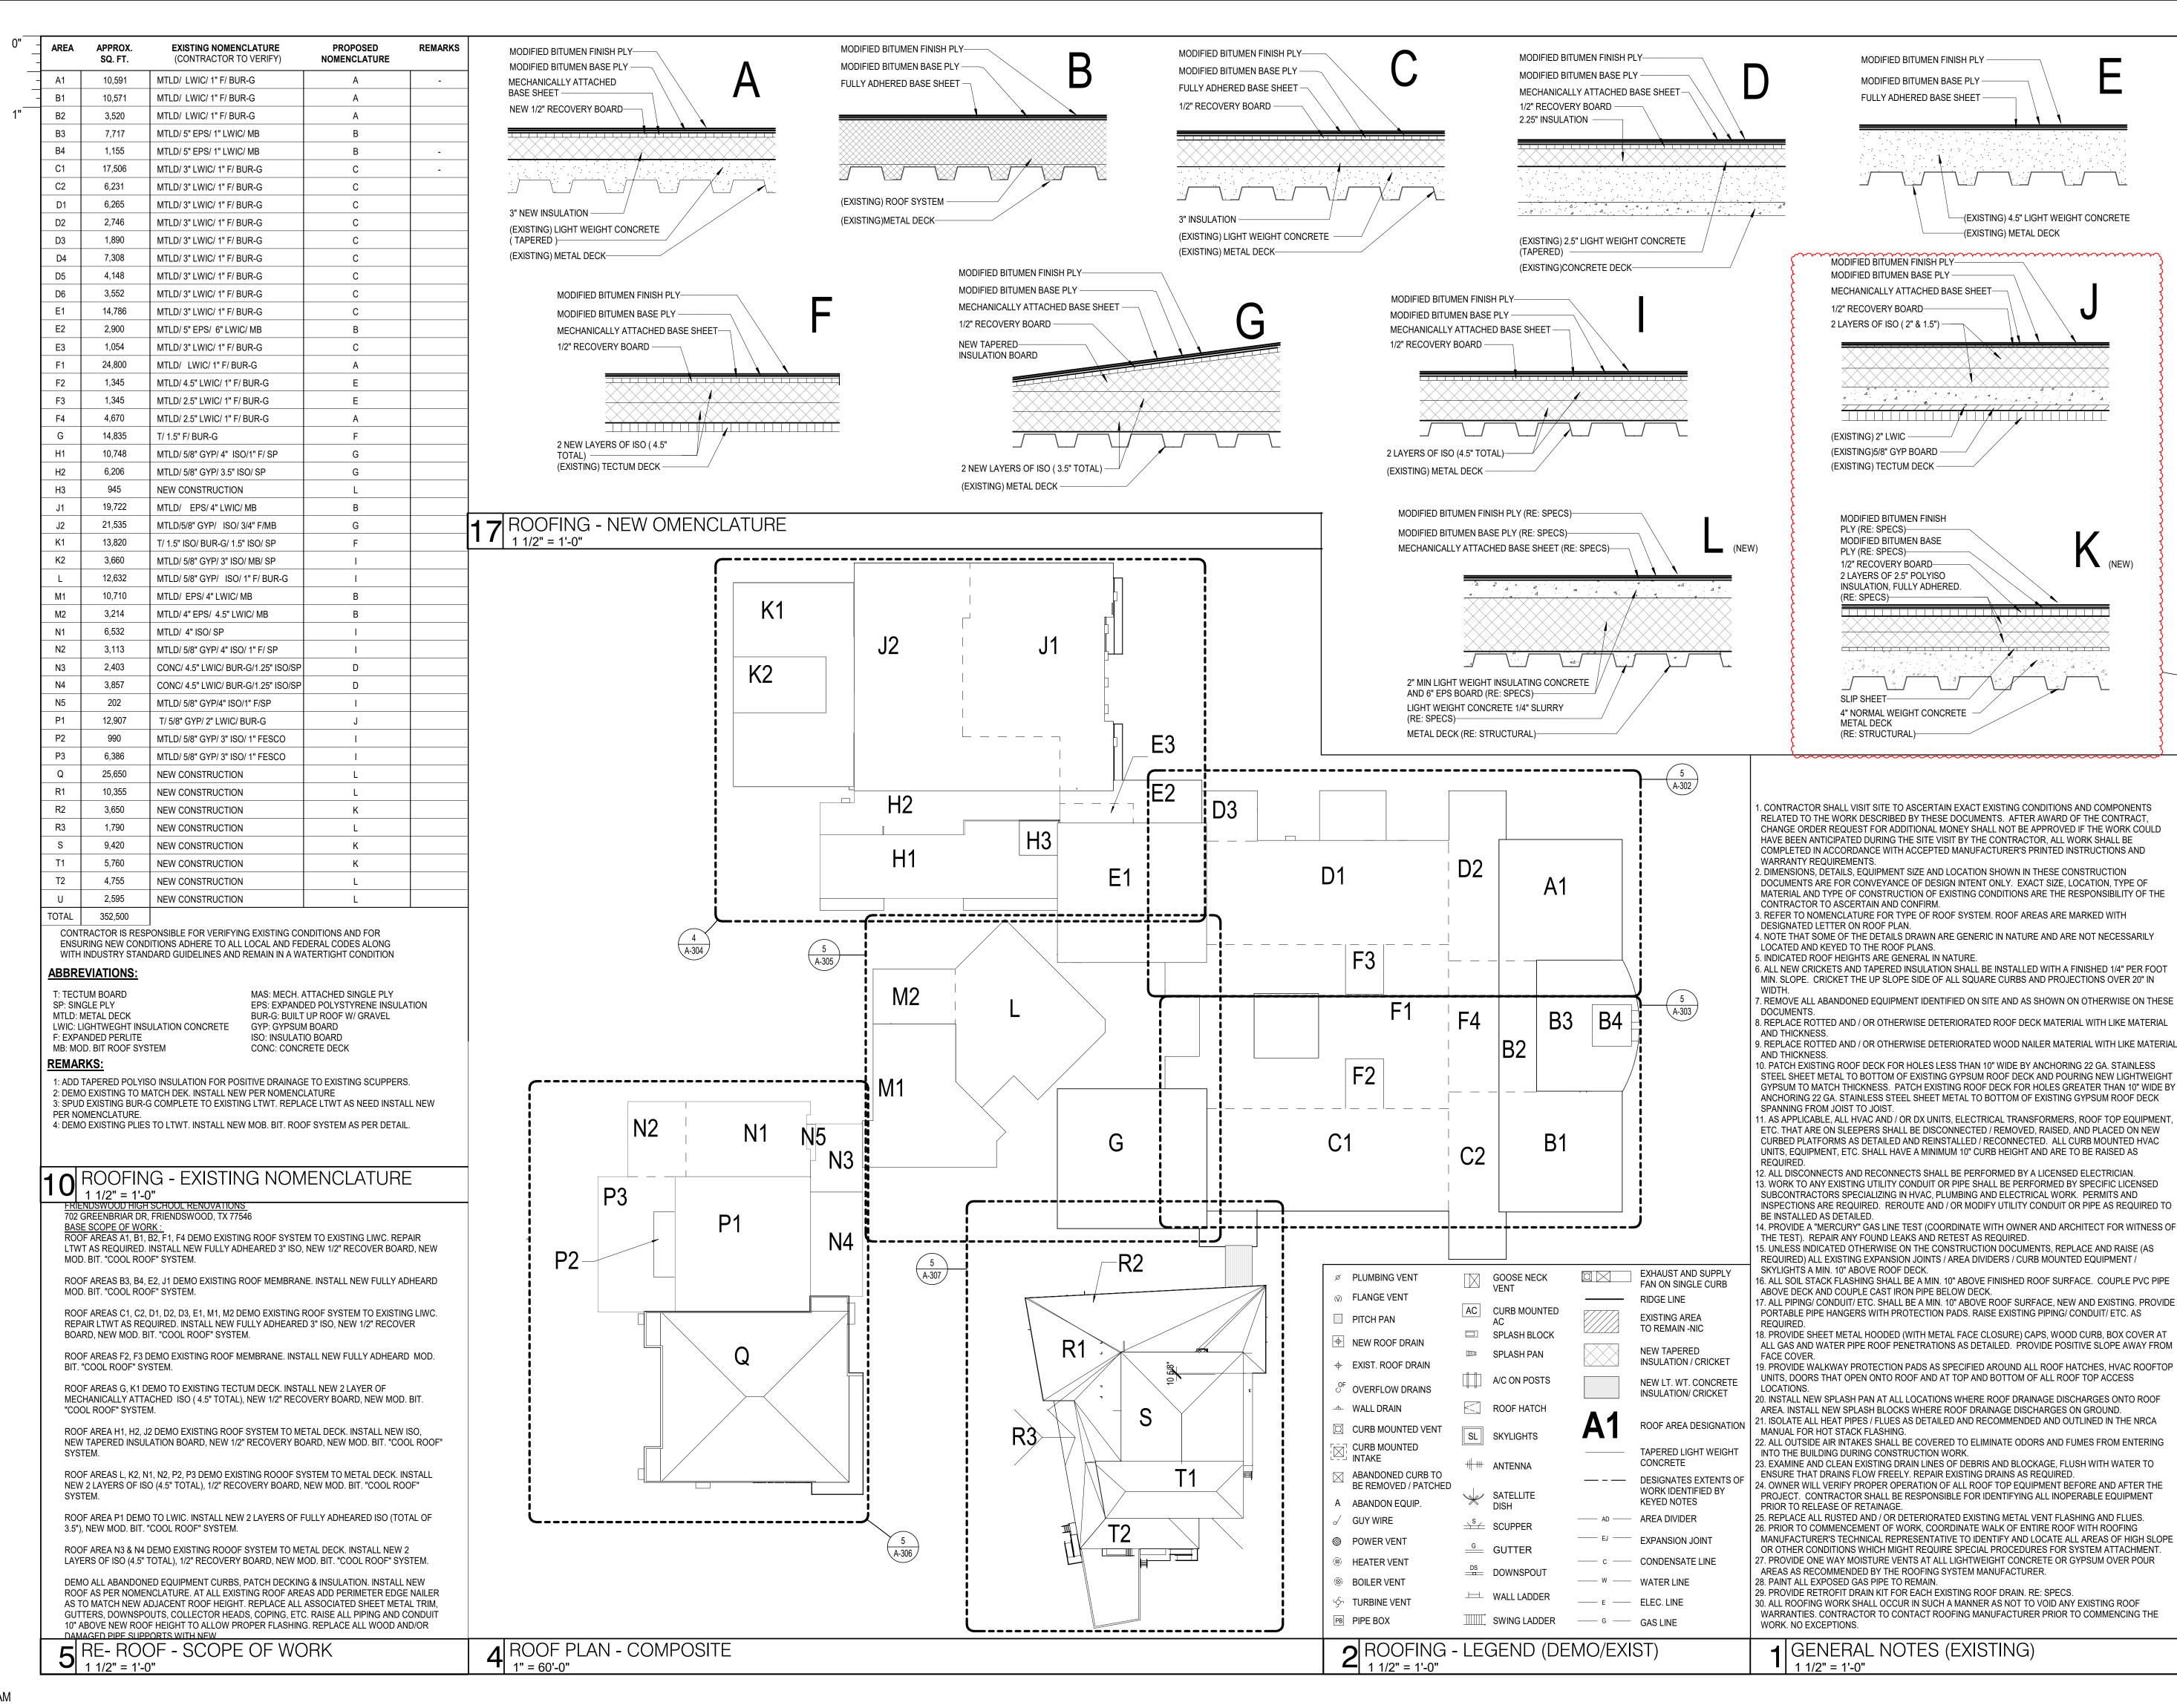






—(EXISTING) 4.5" LIGHT WEIGHT CONCRETE

—(EXISTING) METAL DECK

 \nearrow

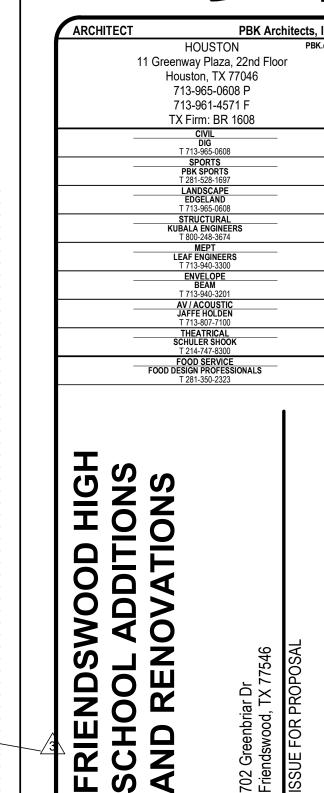

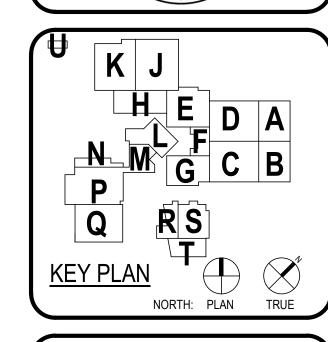

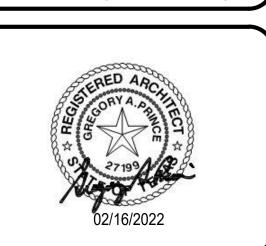

		IENT	
	FRIENDSV	VOOD ISD	
	DATE		CT NUMBER
	02/02/2022	2	.0381
DF	RAWING HISTORY		
No.	Descrip	tion	Date
3	ADDENDUM 03		02/16/2022
	ISSUE FOR	PROPOSAL	


ROOF PLAN


PBK

HOUSTON PBK

FRIENDSWOOD HIGH SCHOOL ADDITIONS AND RENOVATIONS



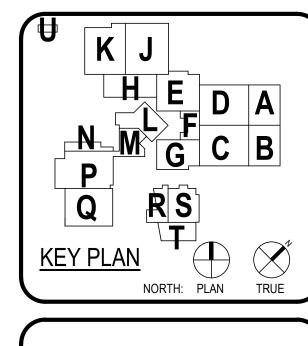

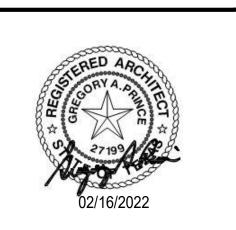

	CL	IENT	
	FRIENDSV	VOOD ISD	
	DATE		CT NUMBER
	02/02/2022	2	20381
DI	RAWING HISTORY		
No.	Descrip	tion	Date
3	ADDENDUM 03		02/16/2022
	ISSUE FOR	DD0D0041	
	ISSUE FOR	PROPOSAL	-

ROOF PLAN - AREA A & D

A-302

CHECKED BY:
Checker
DRAWN BY:
Author
Plot Stamp:
2/16/2022 10:56:43 AM

5 ROOF PLAN - AREA A & D

1) NEW ROOF ACCESS LADDER - RE: 13/A-323 GOOSE NECK VENT EXHAUST AND SUPPLY FAN ON SINGLE CURB Ø PLUMBING VENT (v) FLANGE VENT (2) NEW ROOF HATCH - RE: 12/A-323 (RE: SPECS) PITCH PAN TAPERED (3) ROOF ACCESS DOOR - RE: 2/A-323 (RE: SPECS) ☐ SPLASH BLOCK INSULATION/CRICKET → ROOF DRAIN SPLASH PAN LT. WT. CONCRETE A/C ON SUPPORT CURBS OF OVERFLOW DRAINS INSULATION/ CRICKET 5) RETRO FIT EXISTING DRAINS AS TO MATCH NEW HEIGHT → WALL DRAIN ROOF HATCH **ROOF AREA DESIGNATION** CURB MOUNTED VENT SL SKYLIGHTS TAPERED LIGHT WEIGHT (7) COND. LINE TO PLUMBING VENT CONCRETE CURB MOUNTED ### ANTENNA INTAKE ---- AD ---- AREA DIVIDER SATELLITE DISH √ GUY WIRE EXPANSION JOINT POWER VENT ⇒S SCUPPER (9) NEW ROOF TOP UNIT TO BE INSTALLED. RE: MEP — c — CONDENSATE LINE GUTTER HEATER VENT DOWNSPOUT. DOWNSPOUT —— w —— water line BOILER VENT ---- E ---- ELEC. LINE (11) EXHAUST CURB DUCTWORK SWING LADDER —— G —— GAS LINE (12) PLUMBING VENT W/ PIPING PB PIPE BOX ROOF LEGEND ROOFING KEYNOTES HORIZONTAL 1 1/2" = 1'-0" 1 1/2" = 1'-0" EJ EJ EJ A-322 A-322 A-322 A-322

FRIENDSWOOD HIGH SCHOOL ADDITIONS AND RENOVATIONS

HOUSTON

11 Greenway Plaza, 22nd Floor

Houston, TX 77046

713-965-0608 P

713-961-4571 F


TX Firm: BR 1608


T 281-528-1697

LANDSCAPE
EDGELAND
T 713-965-0608
STRUCTURAL
KUBALA ENGINEERS
T 800-248-3674
MEPT
LEAF ENGINEERS
T 713-940-3300
ENVELOPE
BEAM
T 713-940-3201
AV / ACOUSTIC
JAFFE HOLDEN
T 713-807-7100
THEATRICAL
SCHULER SHOOK
T 214-747-8300

FOOD SERVICE FOOD DESIGN PROFESSIONALS T 281-350-2323



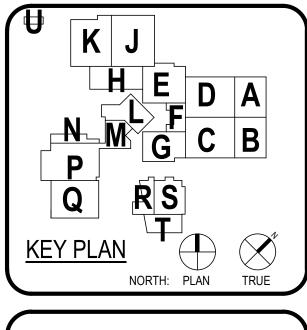


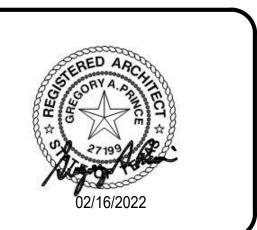

	CL	IENT	
	FRIENDSV	VOOD ISD	
	DATE		CT NUMBER
	02/02/2022	2	20381
DI	RAWING HISTORY		
No.	Descrip	tion	Date
3	ADDENDUM 03		02/16/2022
	ISSUE FOR	DD0D0041	
	ISSUE FOR	PROPOSAL	-

ROOF PLAN - AREA B,C, & F

A-303

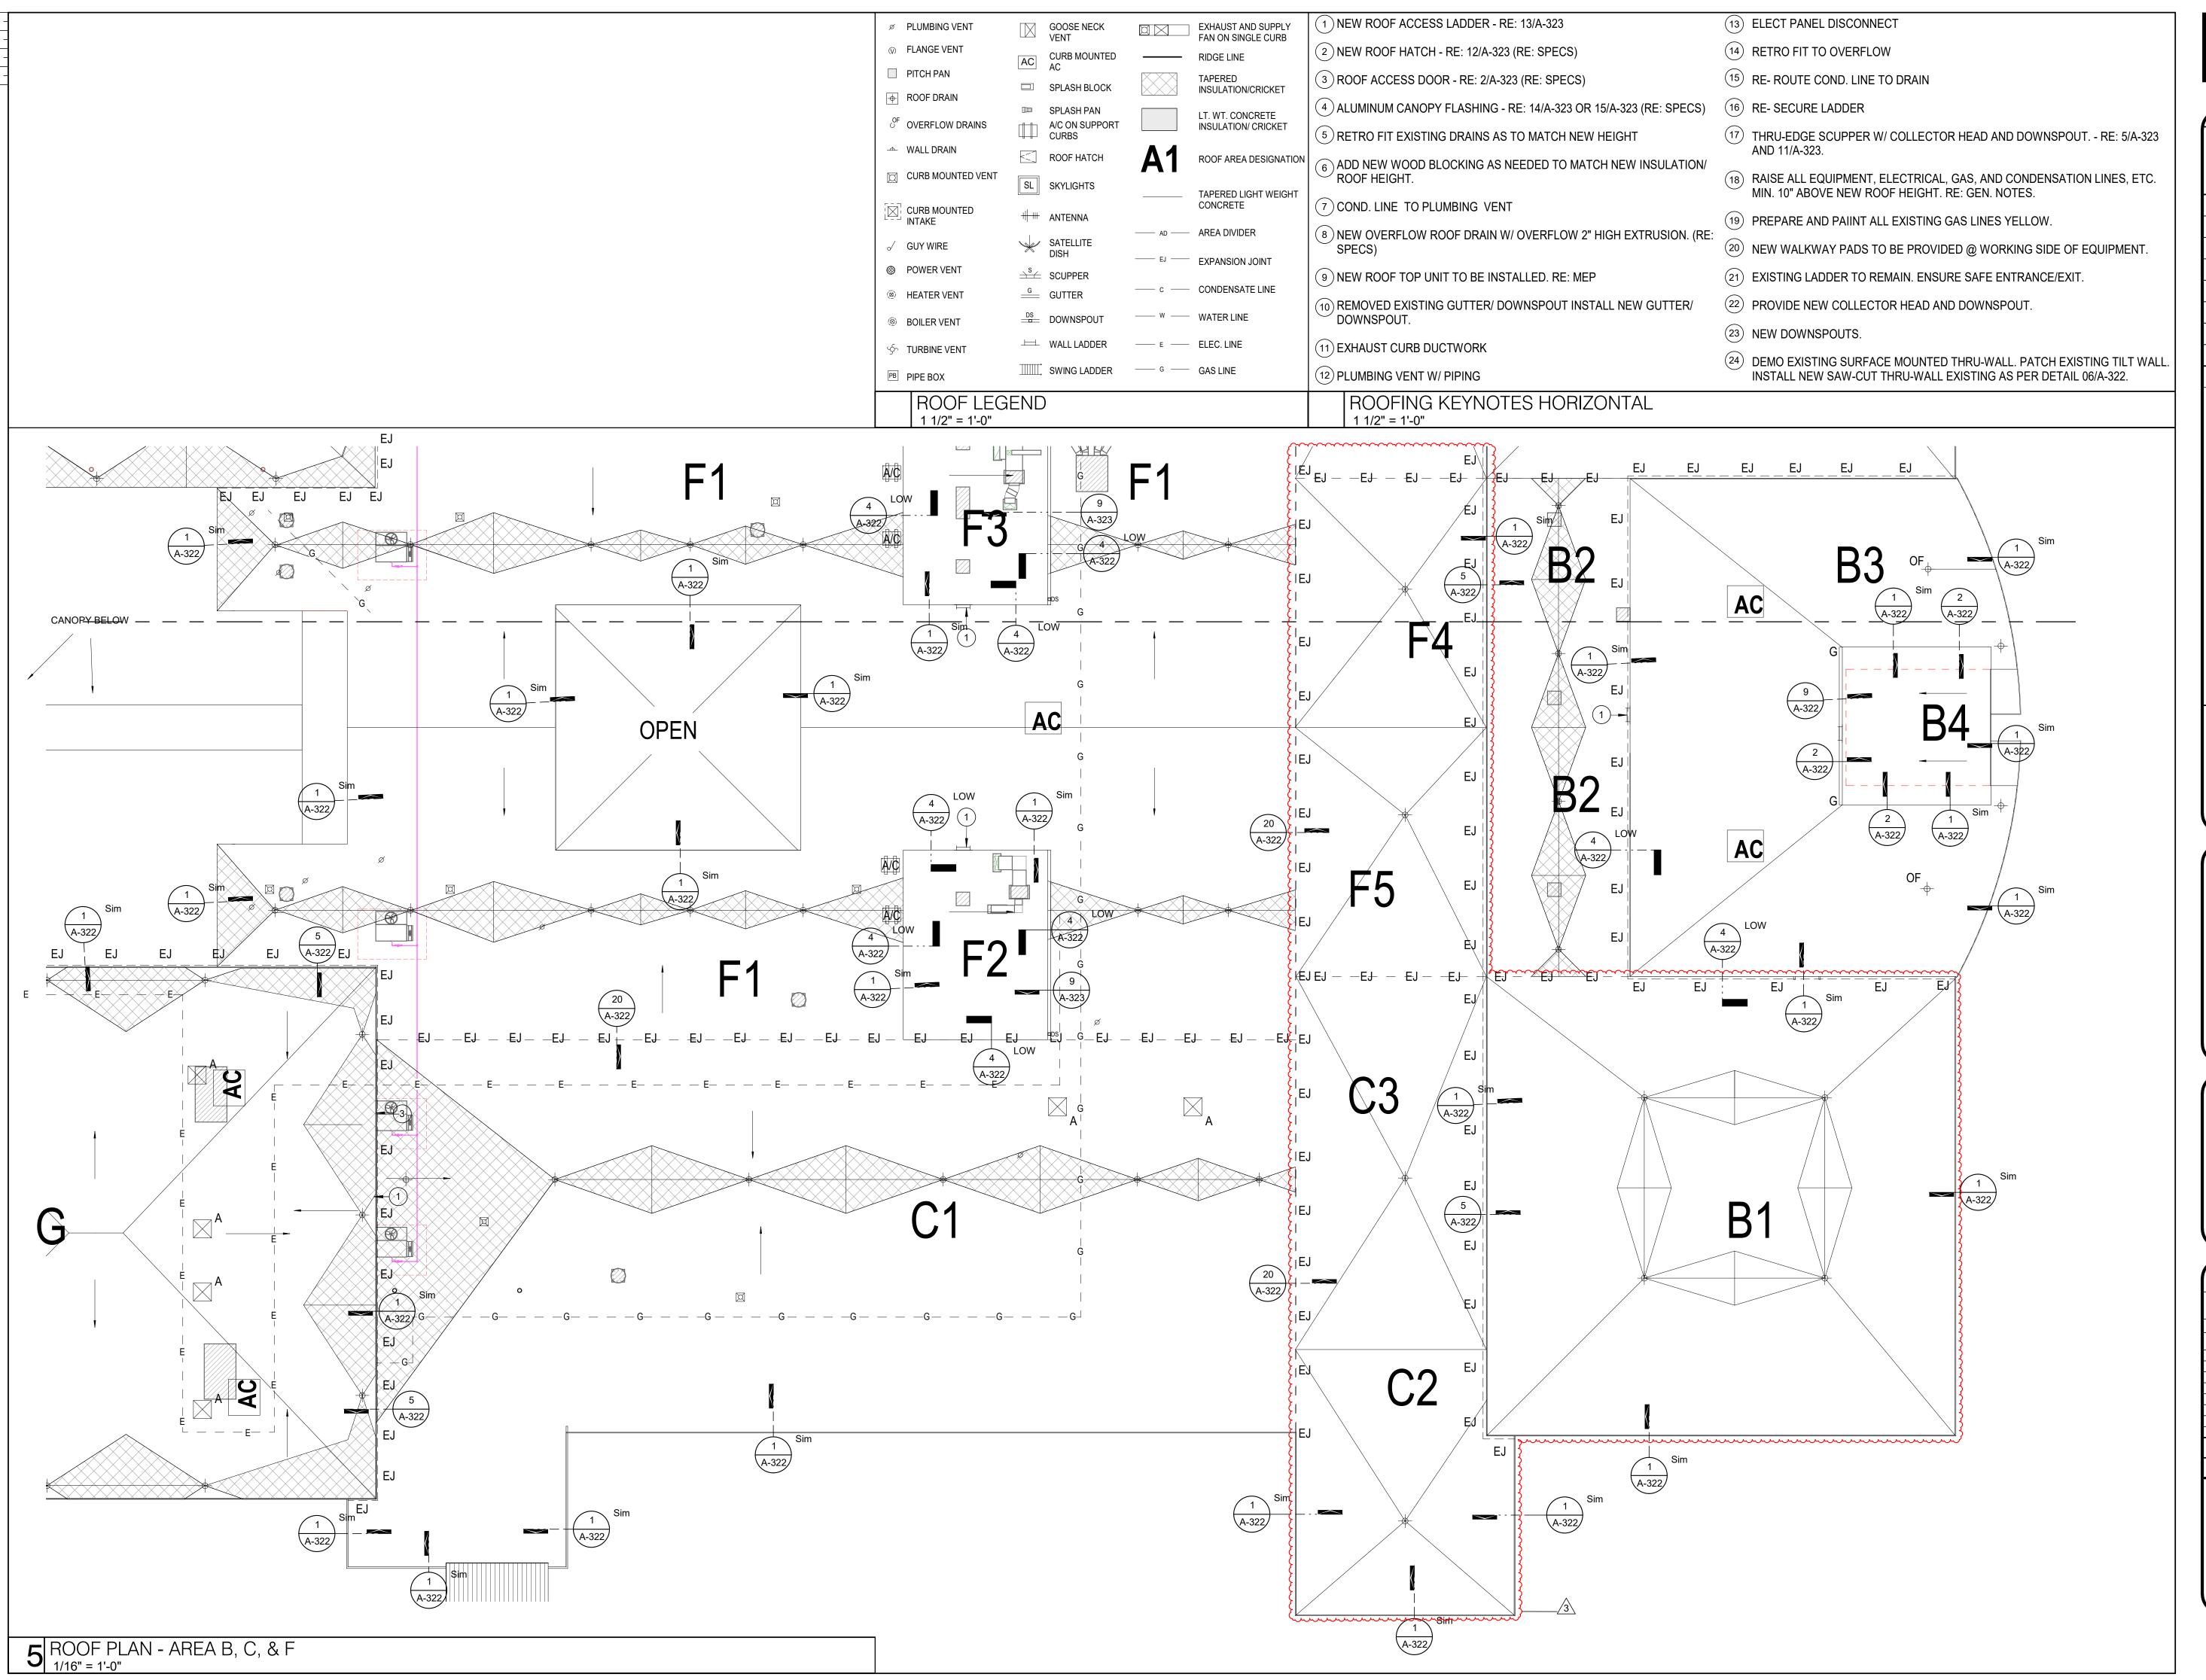

CHECKED BY: Checker **DRAWN BY:** Plot Stamp: 2/16/2022 10:56:55 AM

11 A-323

4 ROOF PLAN - AREA E, H, J, & K

15 A-603

A-322





HOUSTON
11 Greenway Plaza, 22nd Floor
Houston, TX 77046
713-965-0608 P
713-961-4571 F
TX Firm: BR 1608

CIVIL
DIG
T713-965-0608
SPORTS
PBK SPORTS
T 281-528-1697
LANDSCAPE
EDGELAND
T713-965-0608
STRUCTURAL
KUBALA ENGINEERS
T 800-248-3674

MEPT
LEAF ENGINEERS
T 713-940-3300
ENVELOPE
BEAM
T713-940-3201
AV / ACOUSTIC
JAFFE HOLDEN
T713-807-7100
THEATRICAL
SCHULER SHOOK
T 214-747-8300
FOOD SERVICE
FOOD DESIGN PROFESSIONALS
T 281-350-2323

FRIENDSWOOD HIGH SCHOOL ADDITIONS AND RENOVATIONS

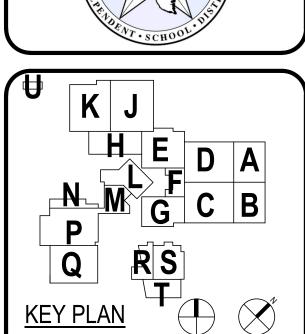

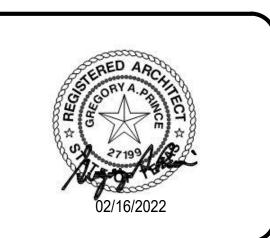

NORTH: PLAN TRUE

		IENT	
	FRIENDSV	VOOD ISD	
DATE PROJECT NUMBER 02/02/2022 20381			-
DF	RAWING HISTORY		
No.	Descrip	Description Date	
3	ADDENDUM 03		02/16/2022
ISSUE FOR PROPOSAL			

ROOF PLAN - AREA E, H, J & K

EJ — EJ— -

EJ EJ


EJ

A-304

CHECKED BY:
Checker
DRAWN BY:
Author
Plot Stamp:
2/16/2022 10:57:05 AM

ROOF LEGEND


1 1/2" = 1'-0"

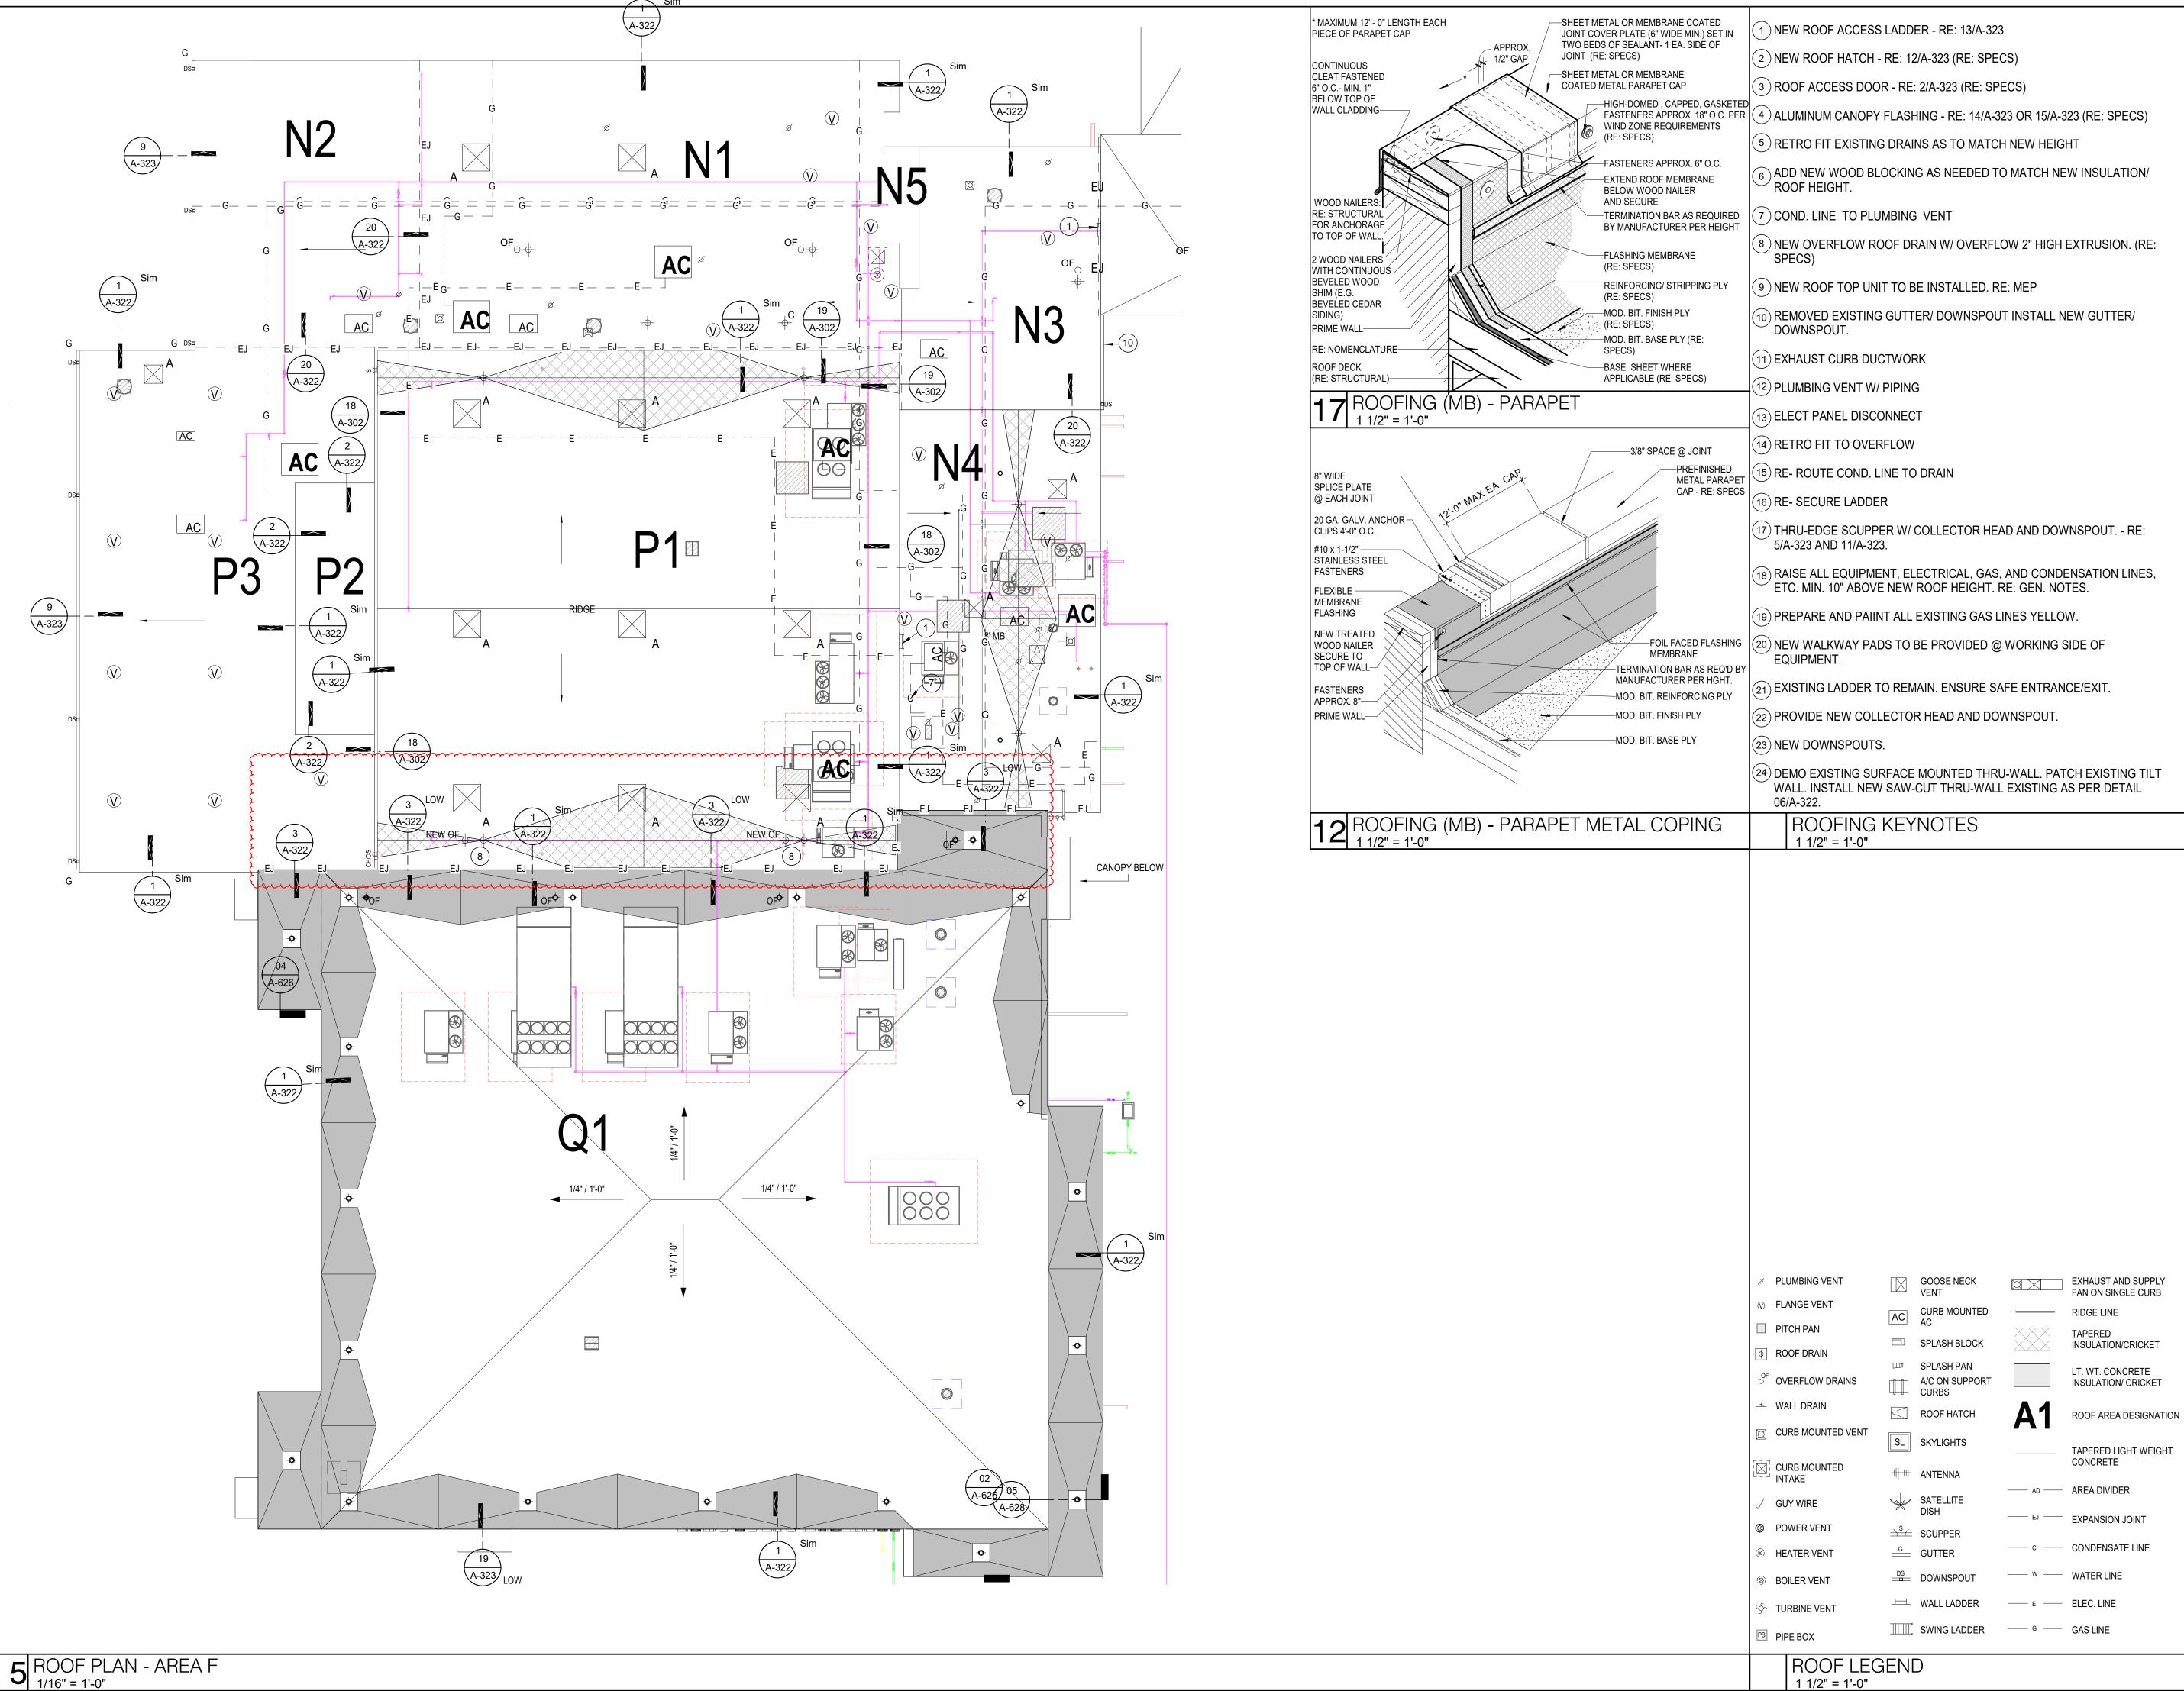





HOUSTON 11 Greenway Plaza, 22nd Floor Houston, TX 77046 713-965-0608 P 713-961-4571 F TX Firm: BR 1608 T 800-248-3674 T 713-807-7100
THEATRICAL
SCHULER SHOOK FOOD SERVICE FOOD DESIGN PROFESSIONALS

FRIENDSWOOD HIGH SCHOOL ADDITIONS AND RENOVATIONS

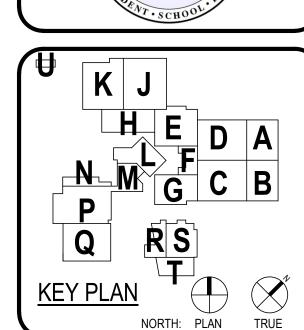

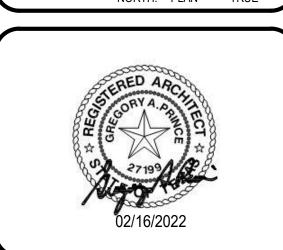


	01	IENT		
	FRIENDSV	IENT WOOD ISD	·	
	DATE PROJECT NUMBE			
	02/02/2022	. 2	0381	
DF	RAWING HISTORY			
No.	Descrip	tion	Date	
3	ADDENDUM 03		02/16/2022	
	ISSUE FOR	PROPOSAL	i	
RC	OF PLAN P 8	_	EA N,	

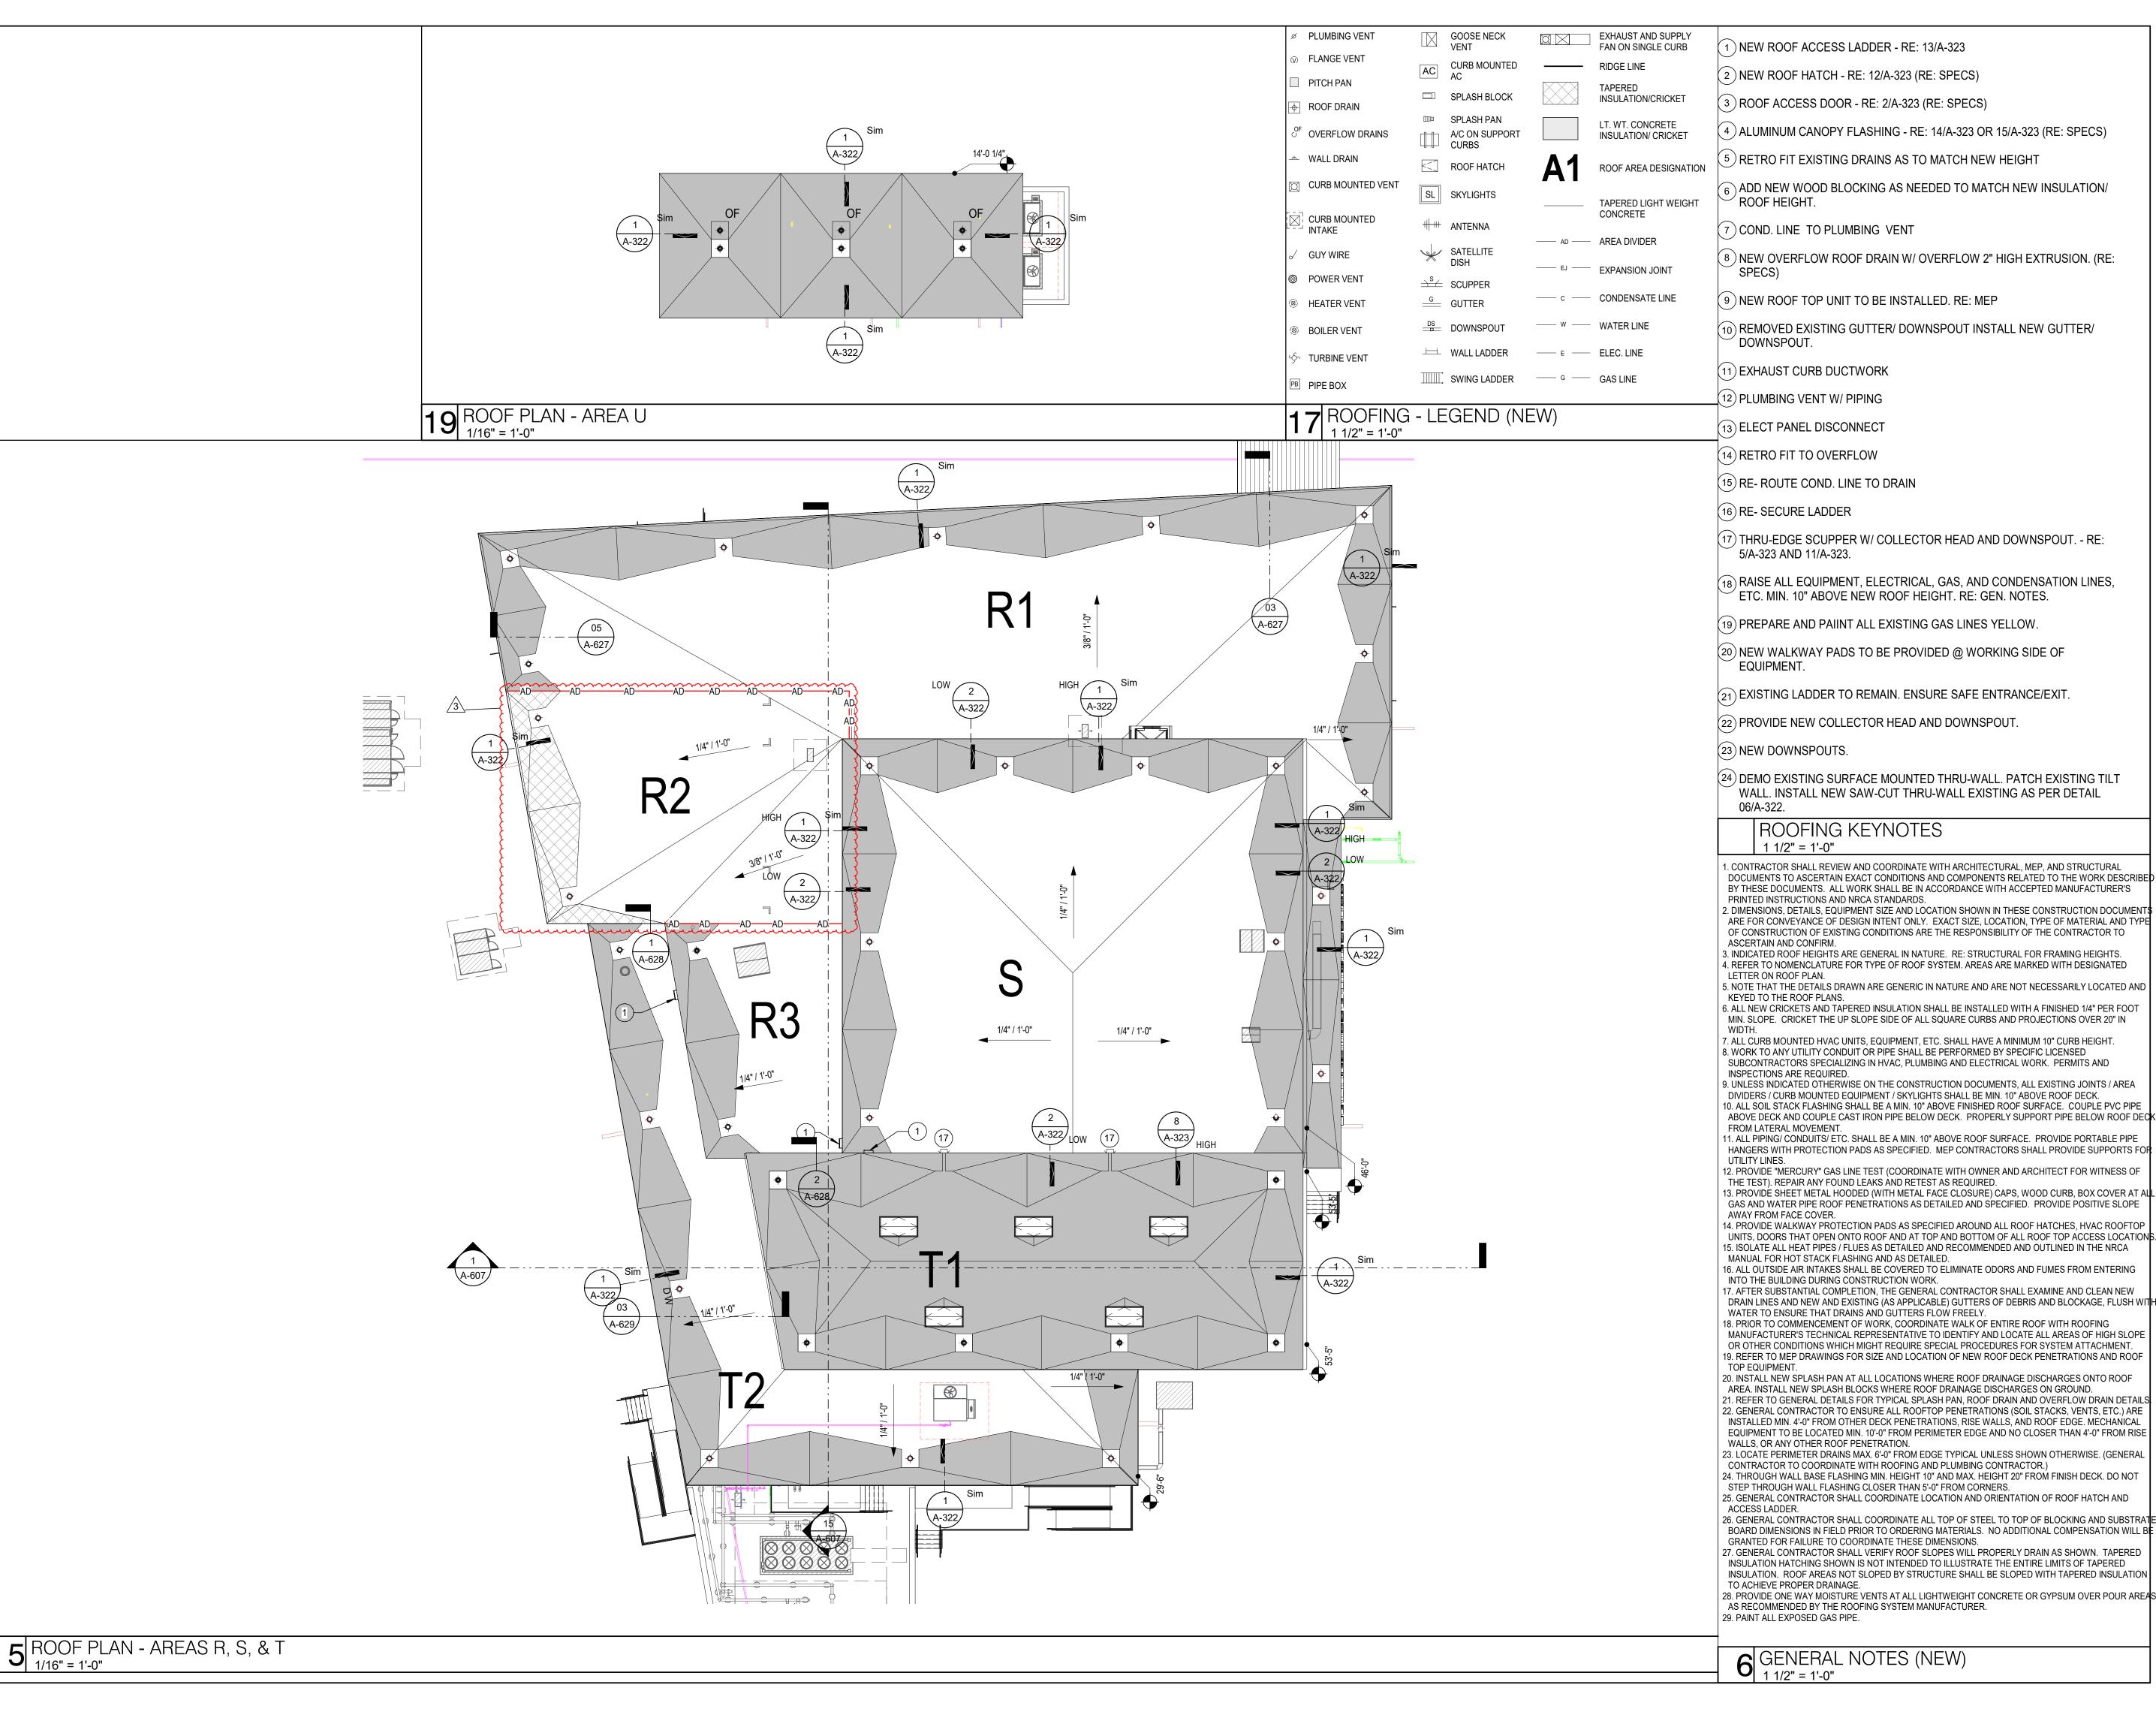





AROTHIEGI	I DIT AIGH	tccto, i
	HOUSTON	PBK.c
	11 Greenway Plaza, 22nd Floor	
	Houston, TX 77046	
	713-965-0608 P	
	713-961-4571 F	
	TX Firm: BR 1608	
	CIVIL	
	DIG T 713-965-0608	
	SPORTS	
	PBK SPORTS T 281-528-1697	
	LANDSCAPE	
	EDGELAND	
	T 713-965-0608	
	STRUCTURAL KUBALA ENGINEERS	
	T 800-248-3674	
	MEPT	
	LEAF ENGINEERS T 713-940-3300	
	ENVELOPE	
	BEAM T 742 040 2004	
	T 713-940-3201 AV / ACOUSTIC	
	JAFFE HOLDEN	
	T 713-807-7100	
	THEATRICAL	
	SCHULER SHOOK T 214-747-8300	
	FOOD SERVICE	
	FOOD DESIGN PROFESSIONALS	

FRIENDSWOOD HIGH SCHOOL ADDITIONS AND RENOVATIONS

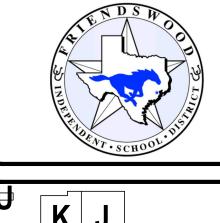

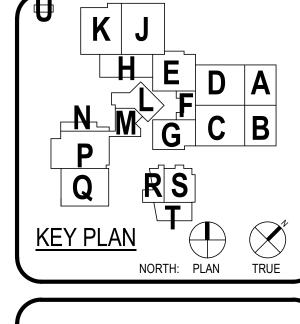

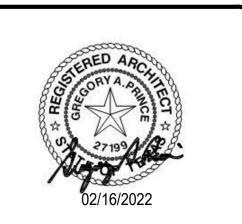

	CL	IENT	
	FRIENDSV	VOOD ISD	
	DATE		CT NUMBER
	02/02/2022	2	0381
DR	RAWING HISTORY		
No.	Description		Date
3	ADDENDUM 03		02/16/2022
	ISSUE FOR	PROPOSAL	


ROOF PLAN - AREAS R, S, T, U

A-307



HOUSTON 11 Greenway Plaza, 22nd Floor Houston, TX 77046 713-965-0608 P 713-961-4571 F TX Firm: BR 1608

FRIENDSWOOD HIGH SCHOOL ADDITIONS AND RENOVATIONS

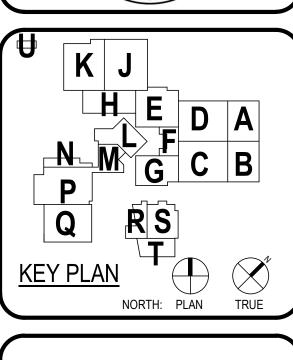



		IENT		
	FRIENDSV	VOOD ISD		
	DATE		CT NUMBER	
	02/02/2022	2	0381	
DF	RAWING HISTORY			
No.	Descrip	tion	Date	
3	ADDENDUM 03		02/16/2022	
	ICCUE FOR	DDODOCAL		
	ISSUE FOR	PRUPUSAL		
ENLADOED				

ENLARGED **RESTROOM ELEVATIONS**

CHECKED BY:


Checker

Author

DRAWN BY:

Plot Stamp:

2/16/2022 10:12:50 PM

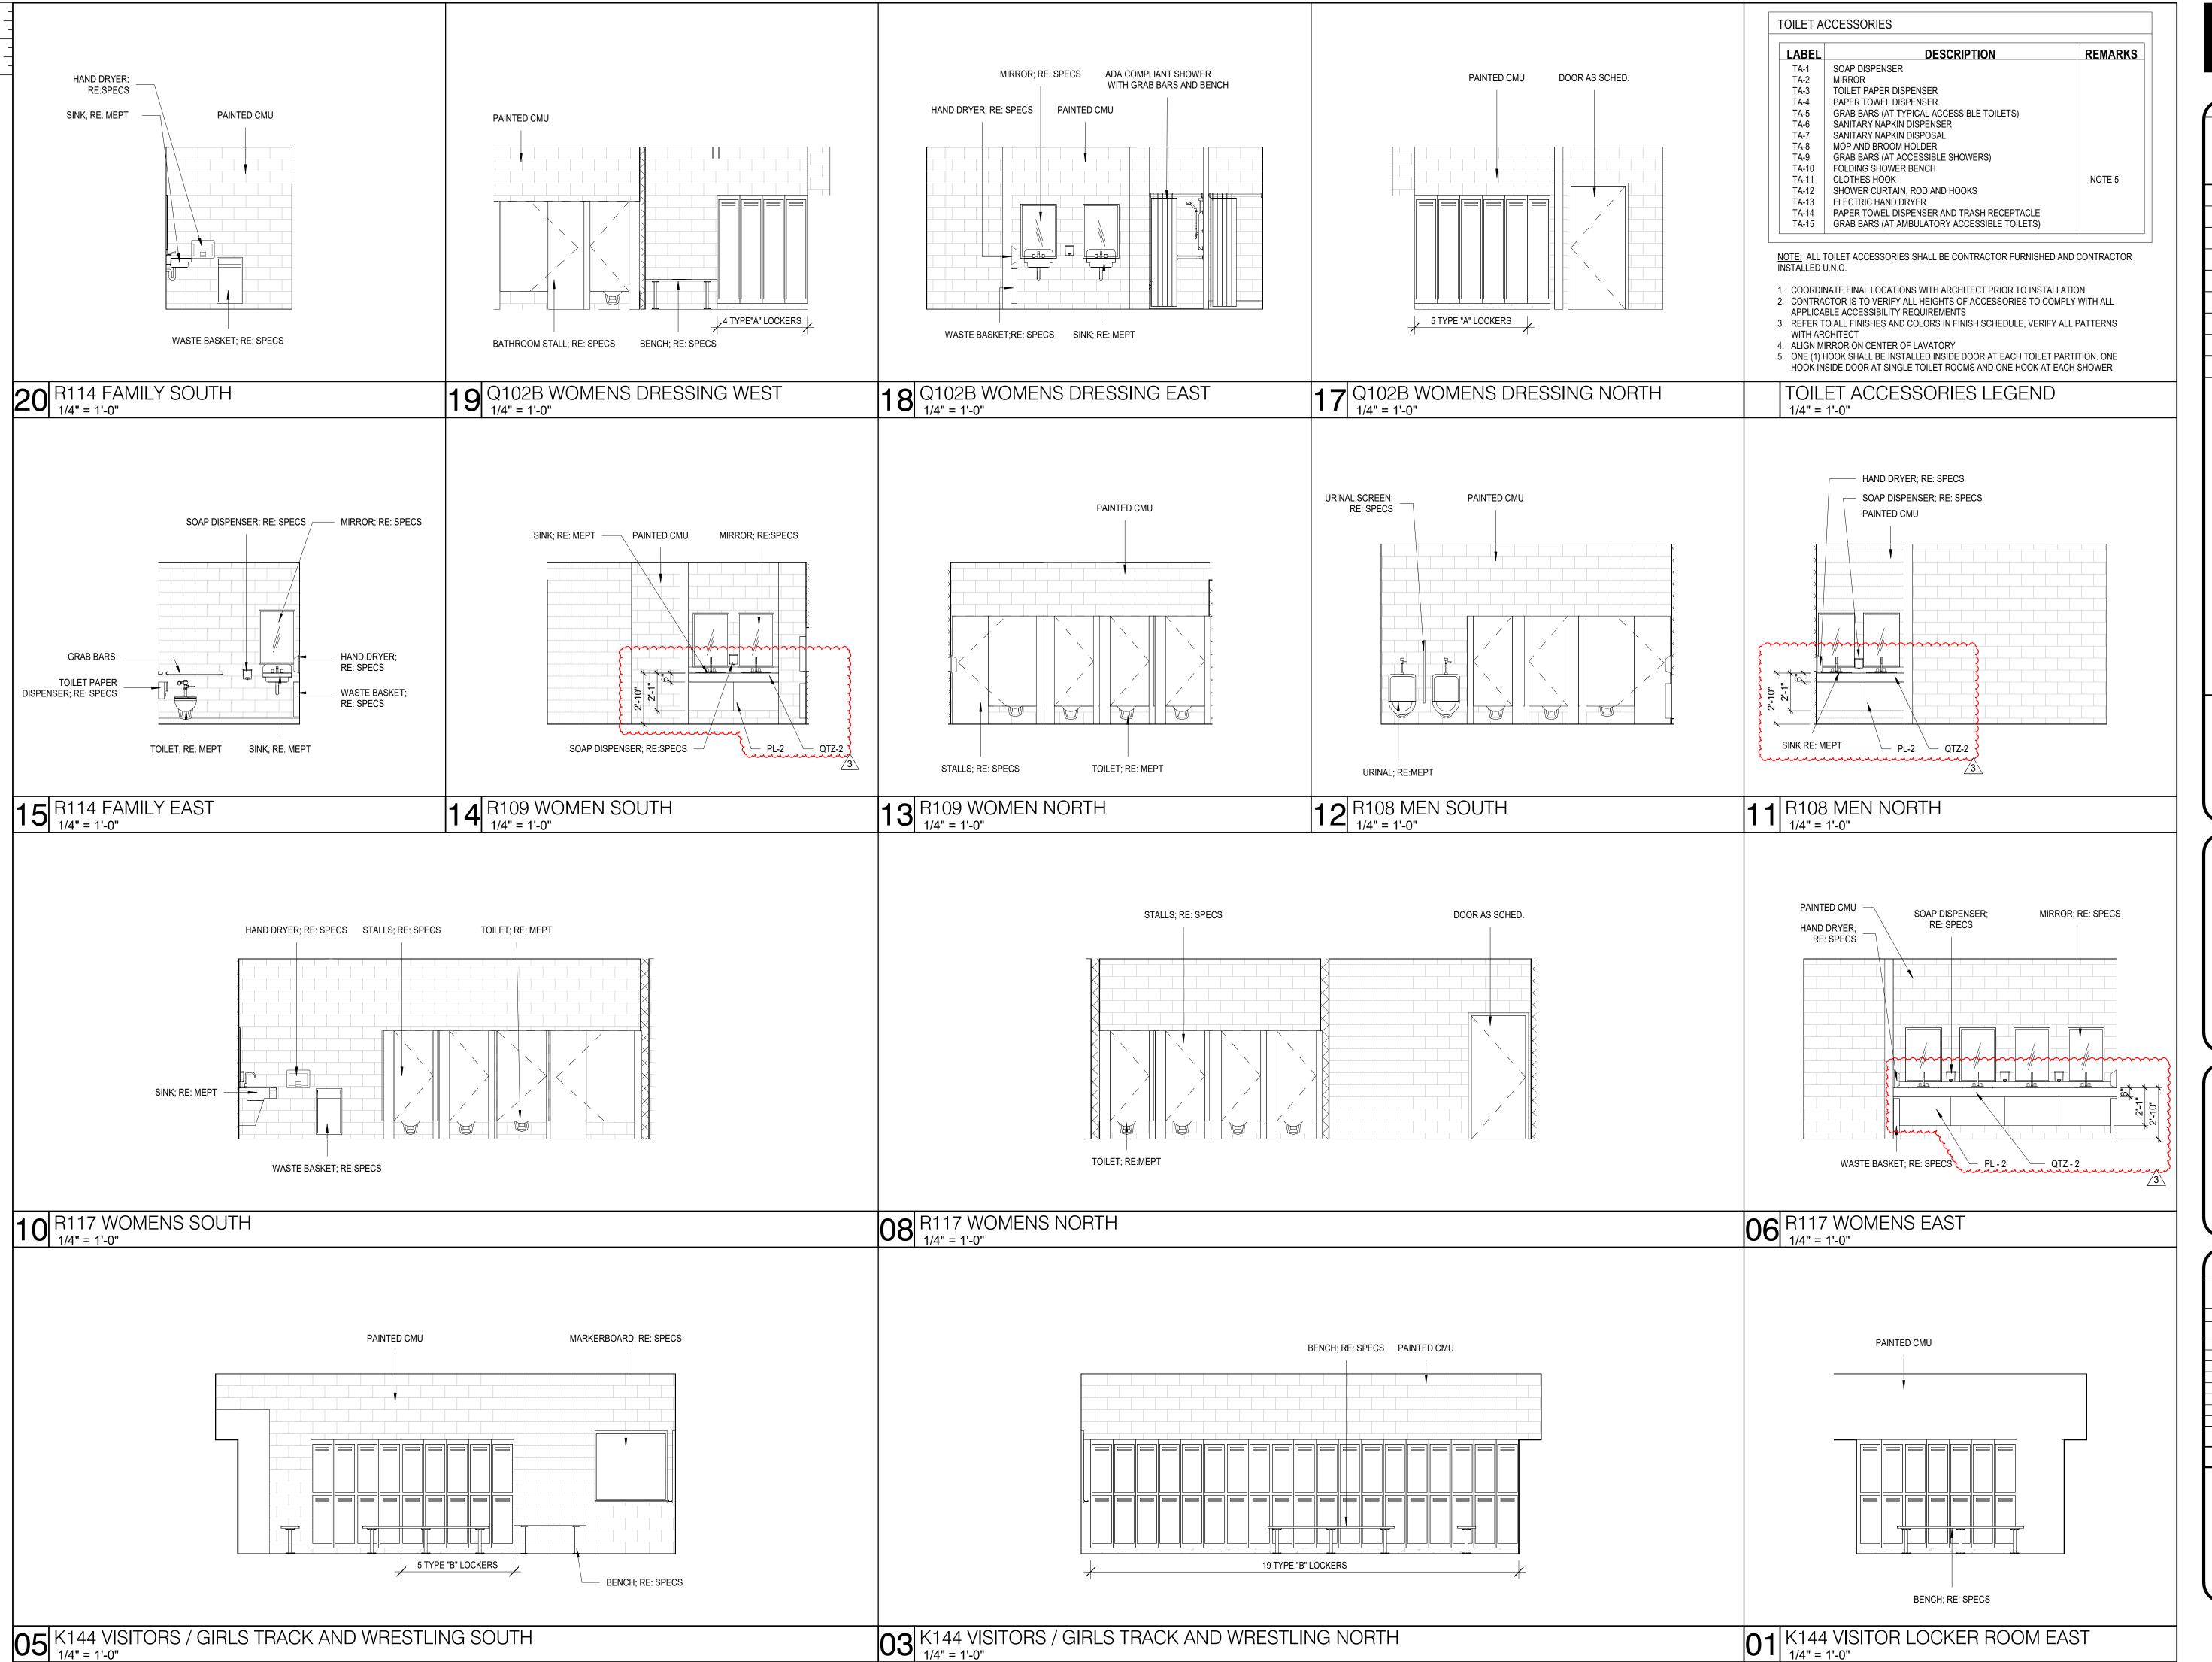


PBK

PRIENDSWOOD HIGH
SCHILER SHOOK
SCHILER SHOOK
SCHILER SHOOK
1214-14-8300
FOOD SERVICE
FOOD DESIGN PROFESSIONALS
T 281-350-2323


702 Greenbriar Dr
Friendswood, TX 77546

SCHO
AND F

702 Greenbria
Friendswood,
Friendswood,

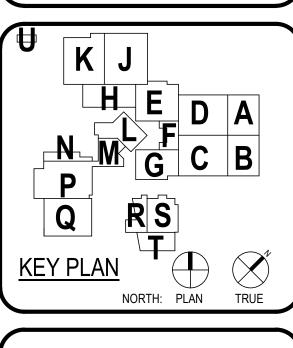




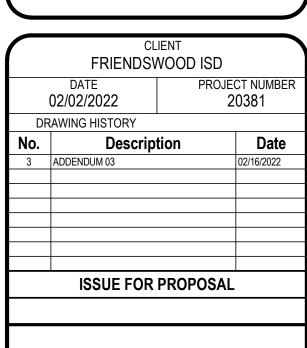

ENLARGED RESTROOM ELEVATIONS

A-405

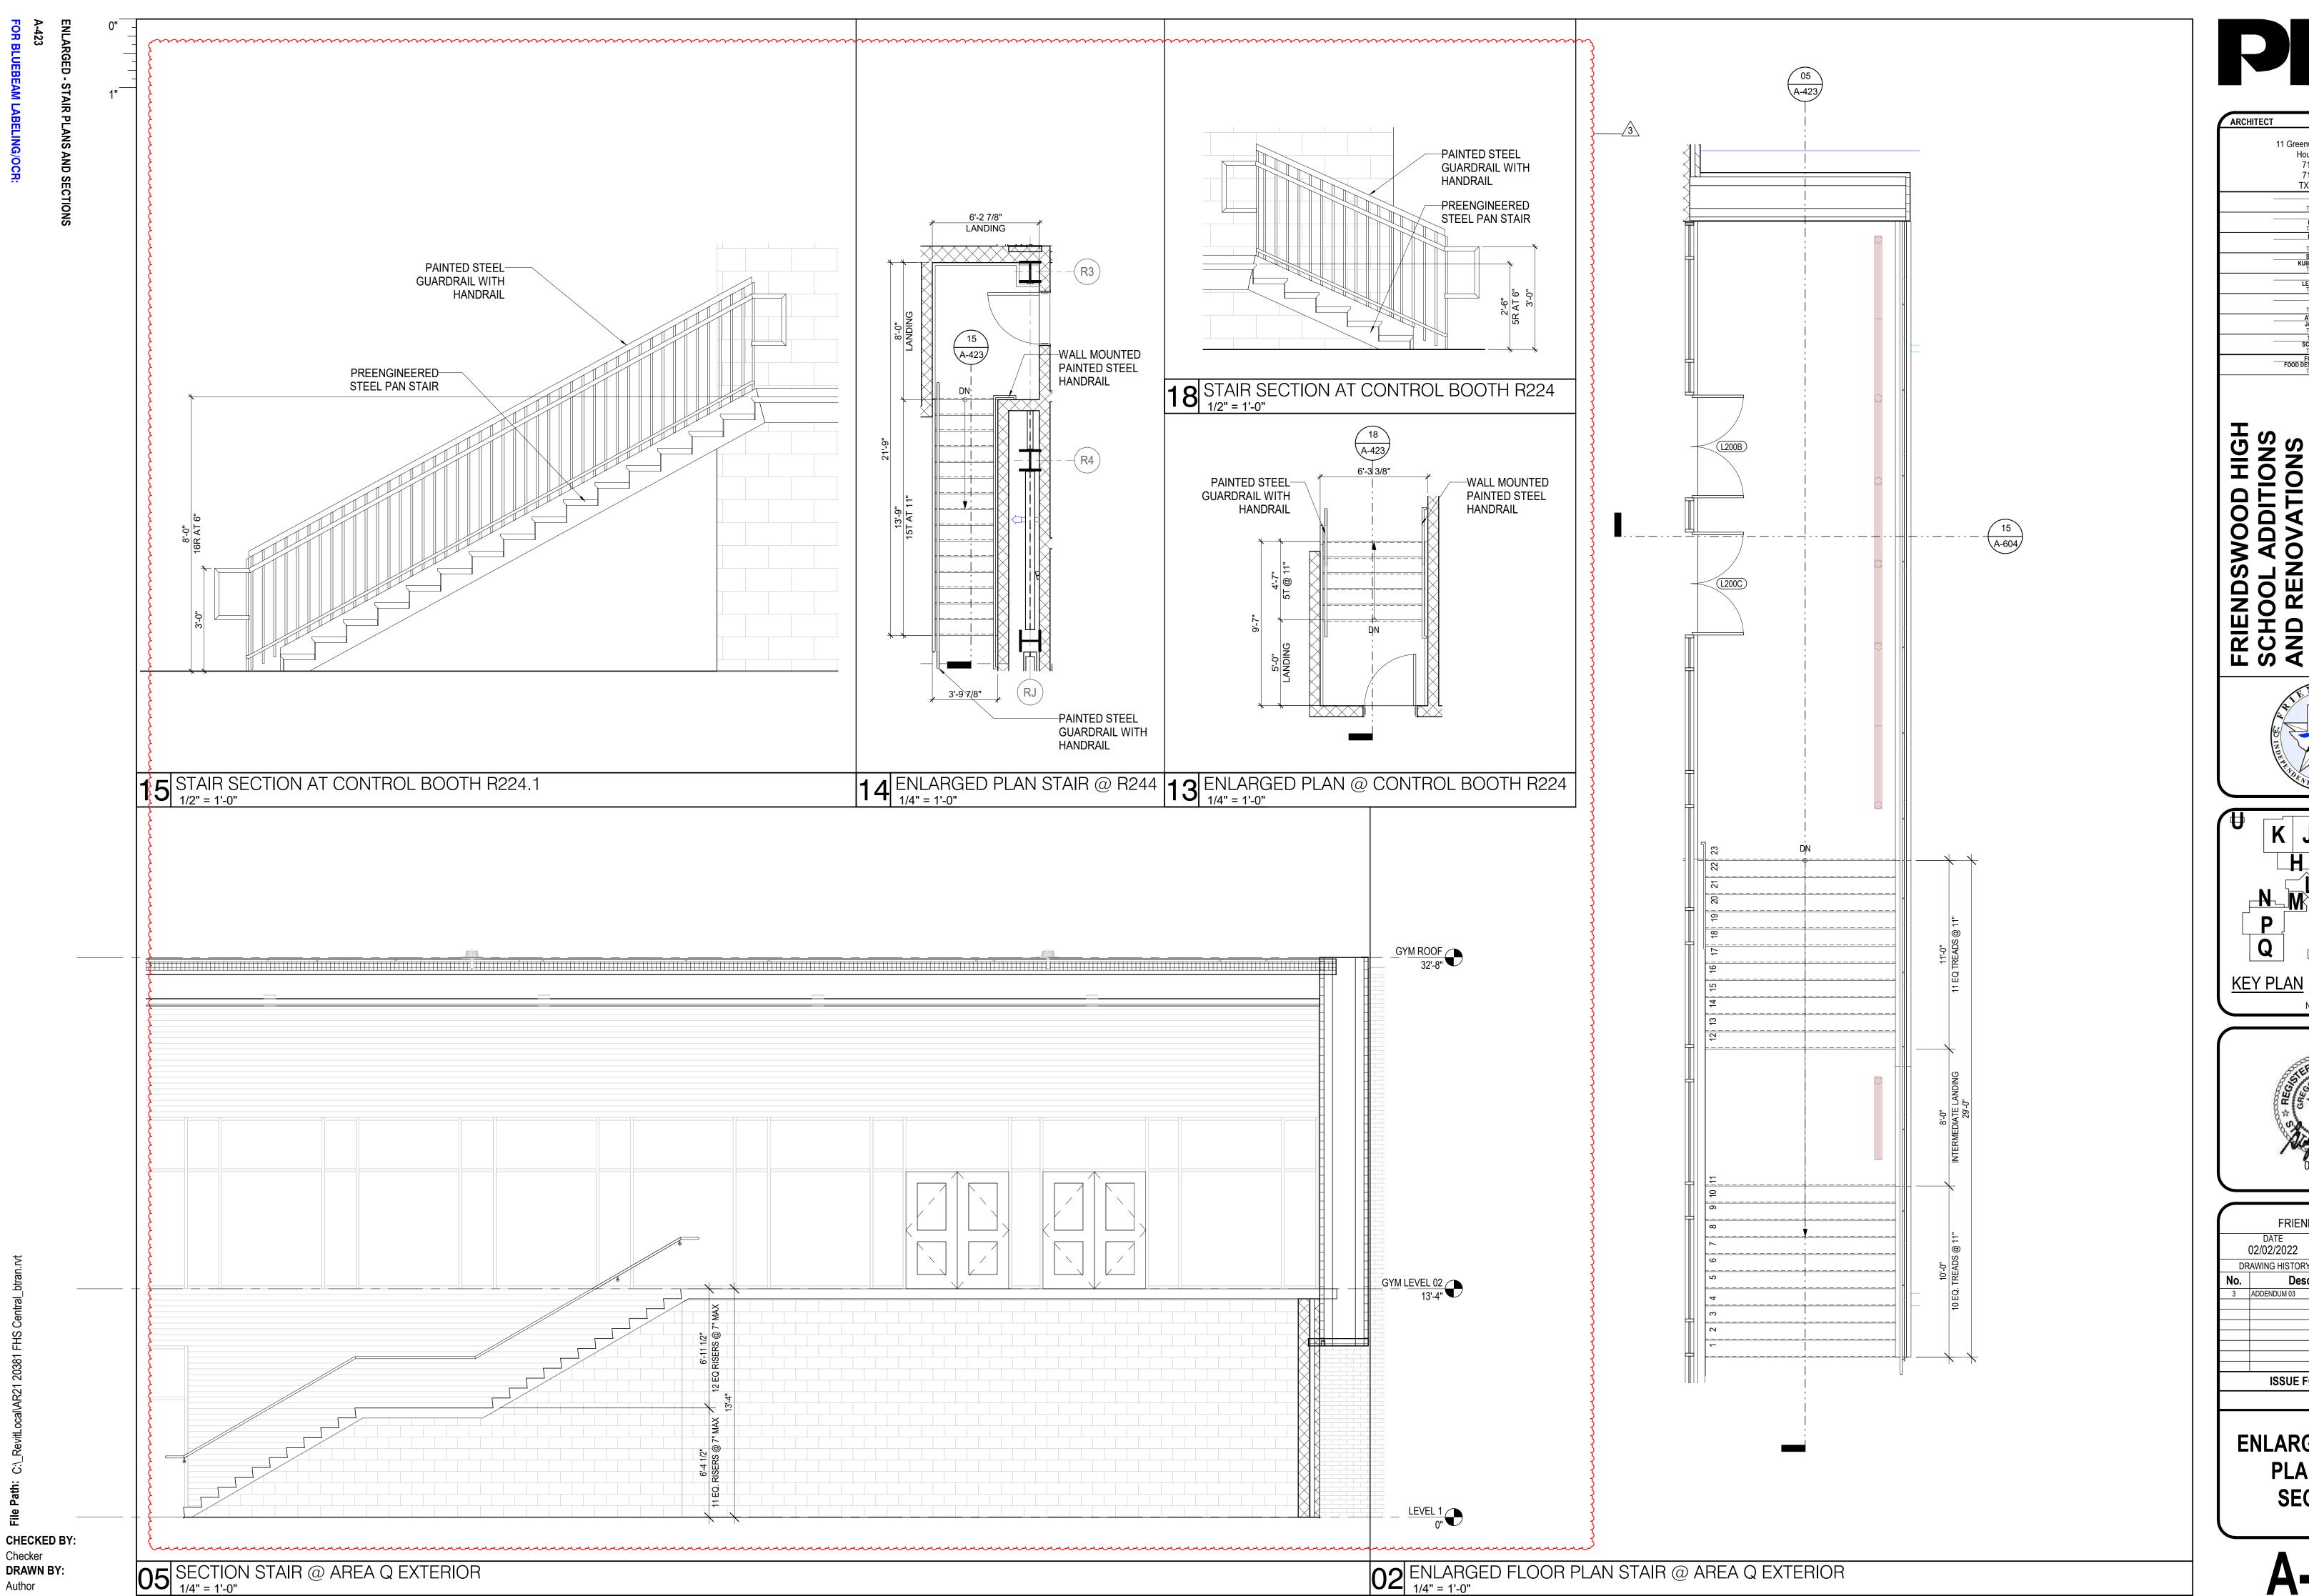


Checker

Author

Plot Stamp:

2/16/2022 9:33:44 PM

HOUSTON 11 Greenway Plaza, 22nd Floor Houston, TX 77046 713-965-0608 P 713-961-4571 F TX Firm: BR 1608 FOOD SERVICE FOOD DESIGN PROFESSIONALS T 281-350-2323

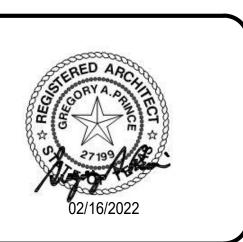

CLIENT FRIENDSWOOD ISD PROJECT NUMBER 20381 02/02/2022 DRAWING HISTORY ISSUE FOR PROPOSAL

ENLARGED - STAIR PLANS AND SECTIONS

ARCHITECT

HOUSTON

HOUSTON

11 Greenway Plaza, 22nd Floor
Houston, TX 77046

713-965-0608 P

713-965-0608 P

713-961-4571 F

TX Firm: BR 1608

CIVIL

DIG

1713-965-0608

SPORTS

PPK SPORTS

PPK SPORTS

1261-528-1697

1261-528-1697

1261-538-528-1697

1261-538-528-1697

1261-538-538-1697

1261-538-538-1697


1261-538-538-1697


1261-538-538-1697

1261-538-538-1697

1261

FRIENDSWOOD HIGH
SCHOOL ADDITIONS
AND RENOVATIONS
702 Greenbriar Dr

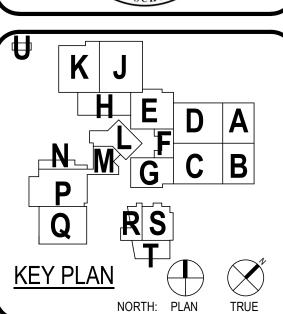

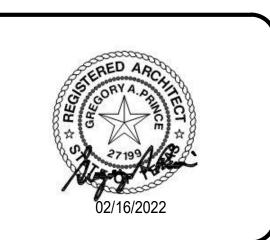


			CT NUMBER	
DI	RAWING HISTORY		0301	
No.	Descrip	tion	Date	
3	ADDENDUM 03		02/16/2022	
	IOOUE FOR	DDODOOAL		
	ISSUE FOR	PROPOSAL	1	
EXTERIOR				

Δ-501


ELEVATIONS

CHECKED BY:
Checker
DRAWN BY:
Author
Plot Stamp:
2/16/2022 10:24:40 PM

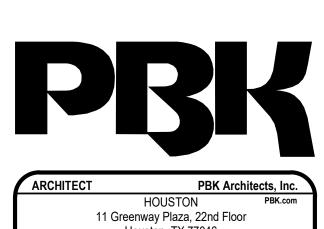

K J H E D A G C B P Q RS

KEY PLAN

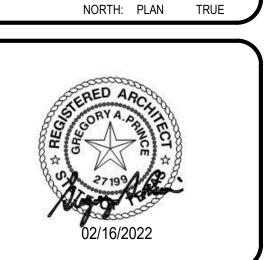

CLIENT
FRIENDSWOOD ISD

DATE PROJECT NUMBER 02/02/2022 20381

DRAWING HISTORY

No. Description Date

3 ADDENDUM 03 02/16/2022


ISSUE FOR PROPOSAL

EXTERIOR

A-502

ELEVATIONS

CHECKED BY:
Checker
DRAWN BY:
Author
Plot Stamp:
2/16/2022 11:08:57 PM

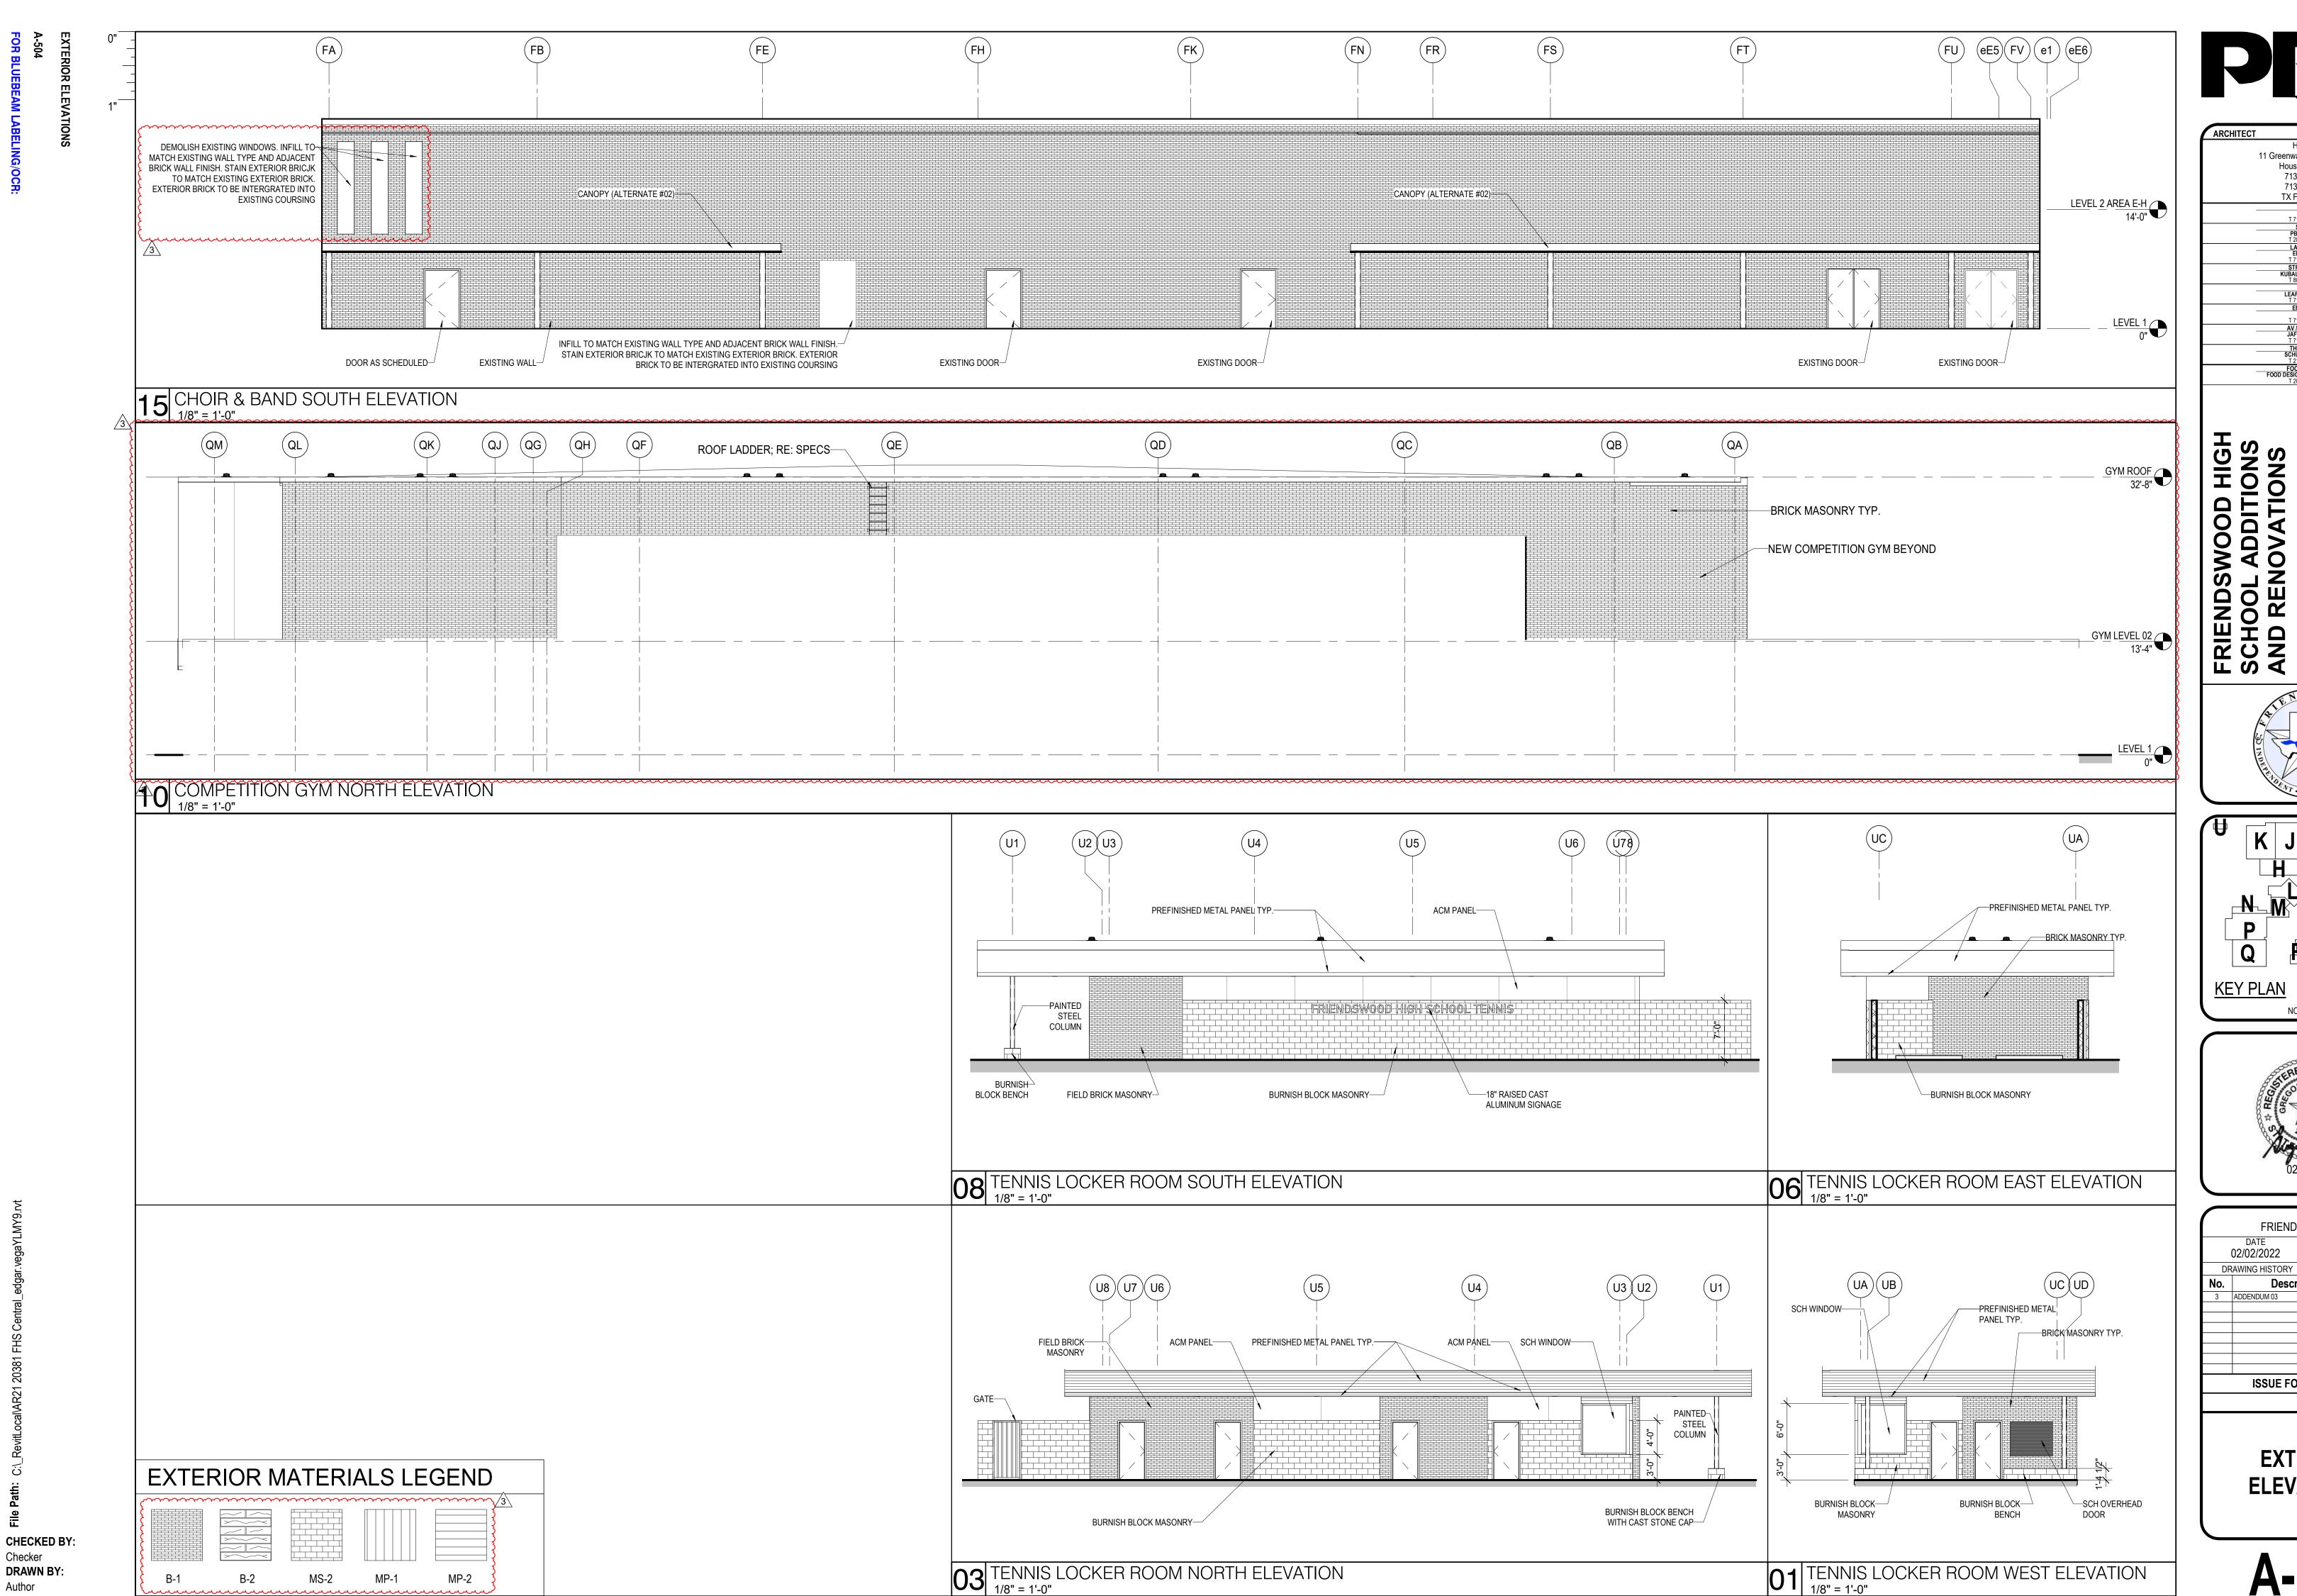

Checker

Author

Plot Stamp:

2/16/2022 10:17:21 PM

HOUSTON

11 Greenway Plaza, 22nd Floor

Houston, TX 77046

713-965-0608 P 713-961-4571 F

TX Firm: BR 1608

FOOD SERVICE FOOD DESIGN PROFESSIONALS T 281-350-2323

RS

CLIENT FRIENDSWOOD ISD

Description

ISSUE FOR PROPOSAL

EXTERIOR


ELEVATIONS

PROJECT NUMBER

20381

Date

NORTH: PLAN TRUE

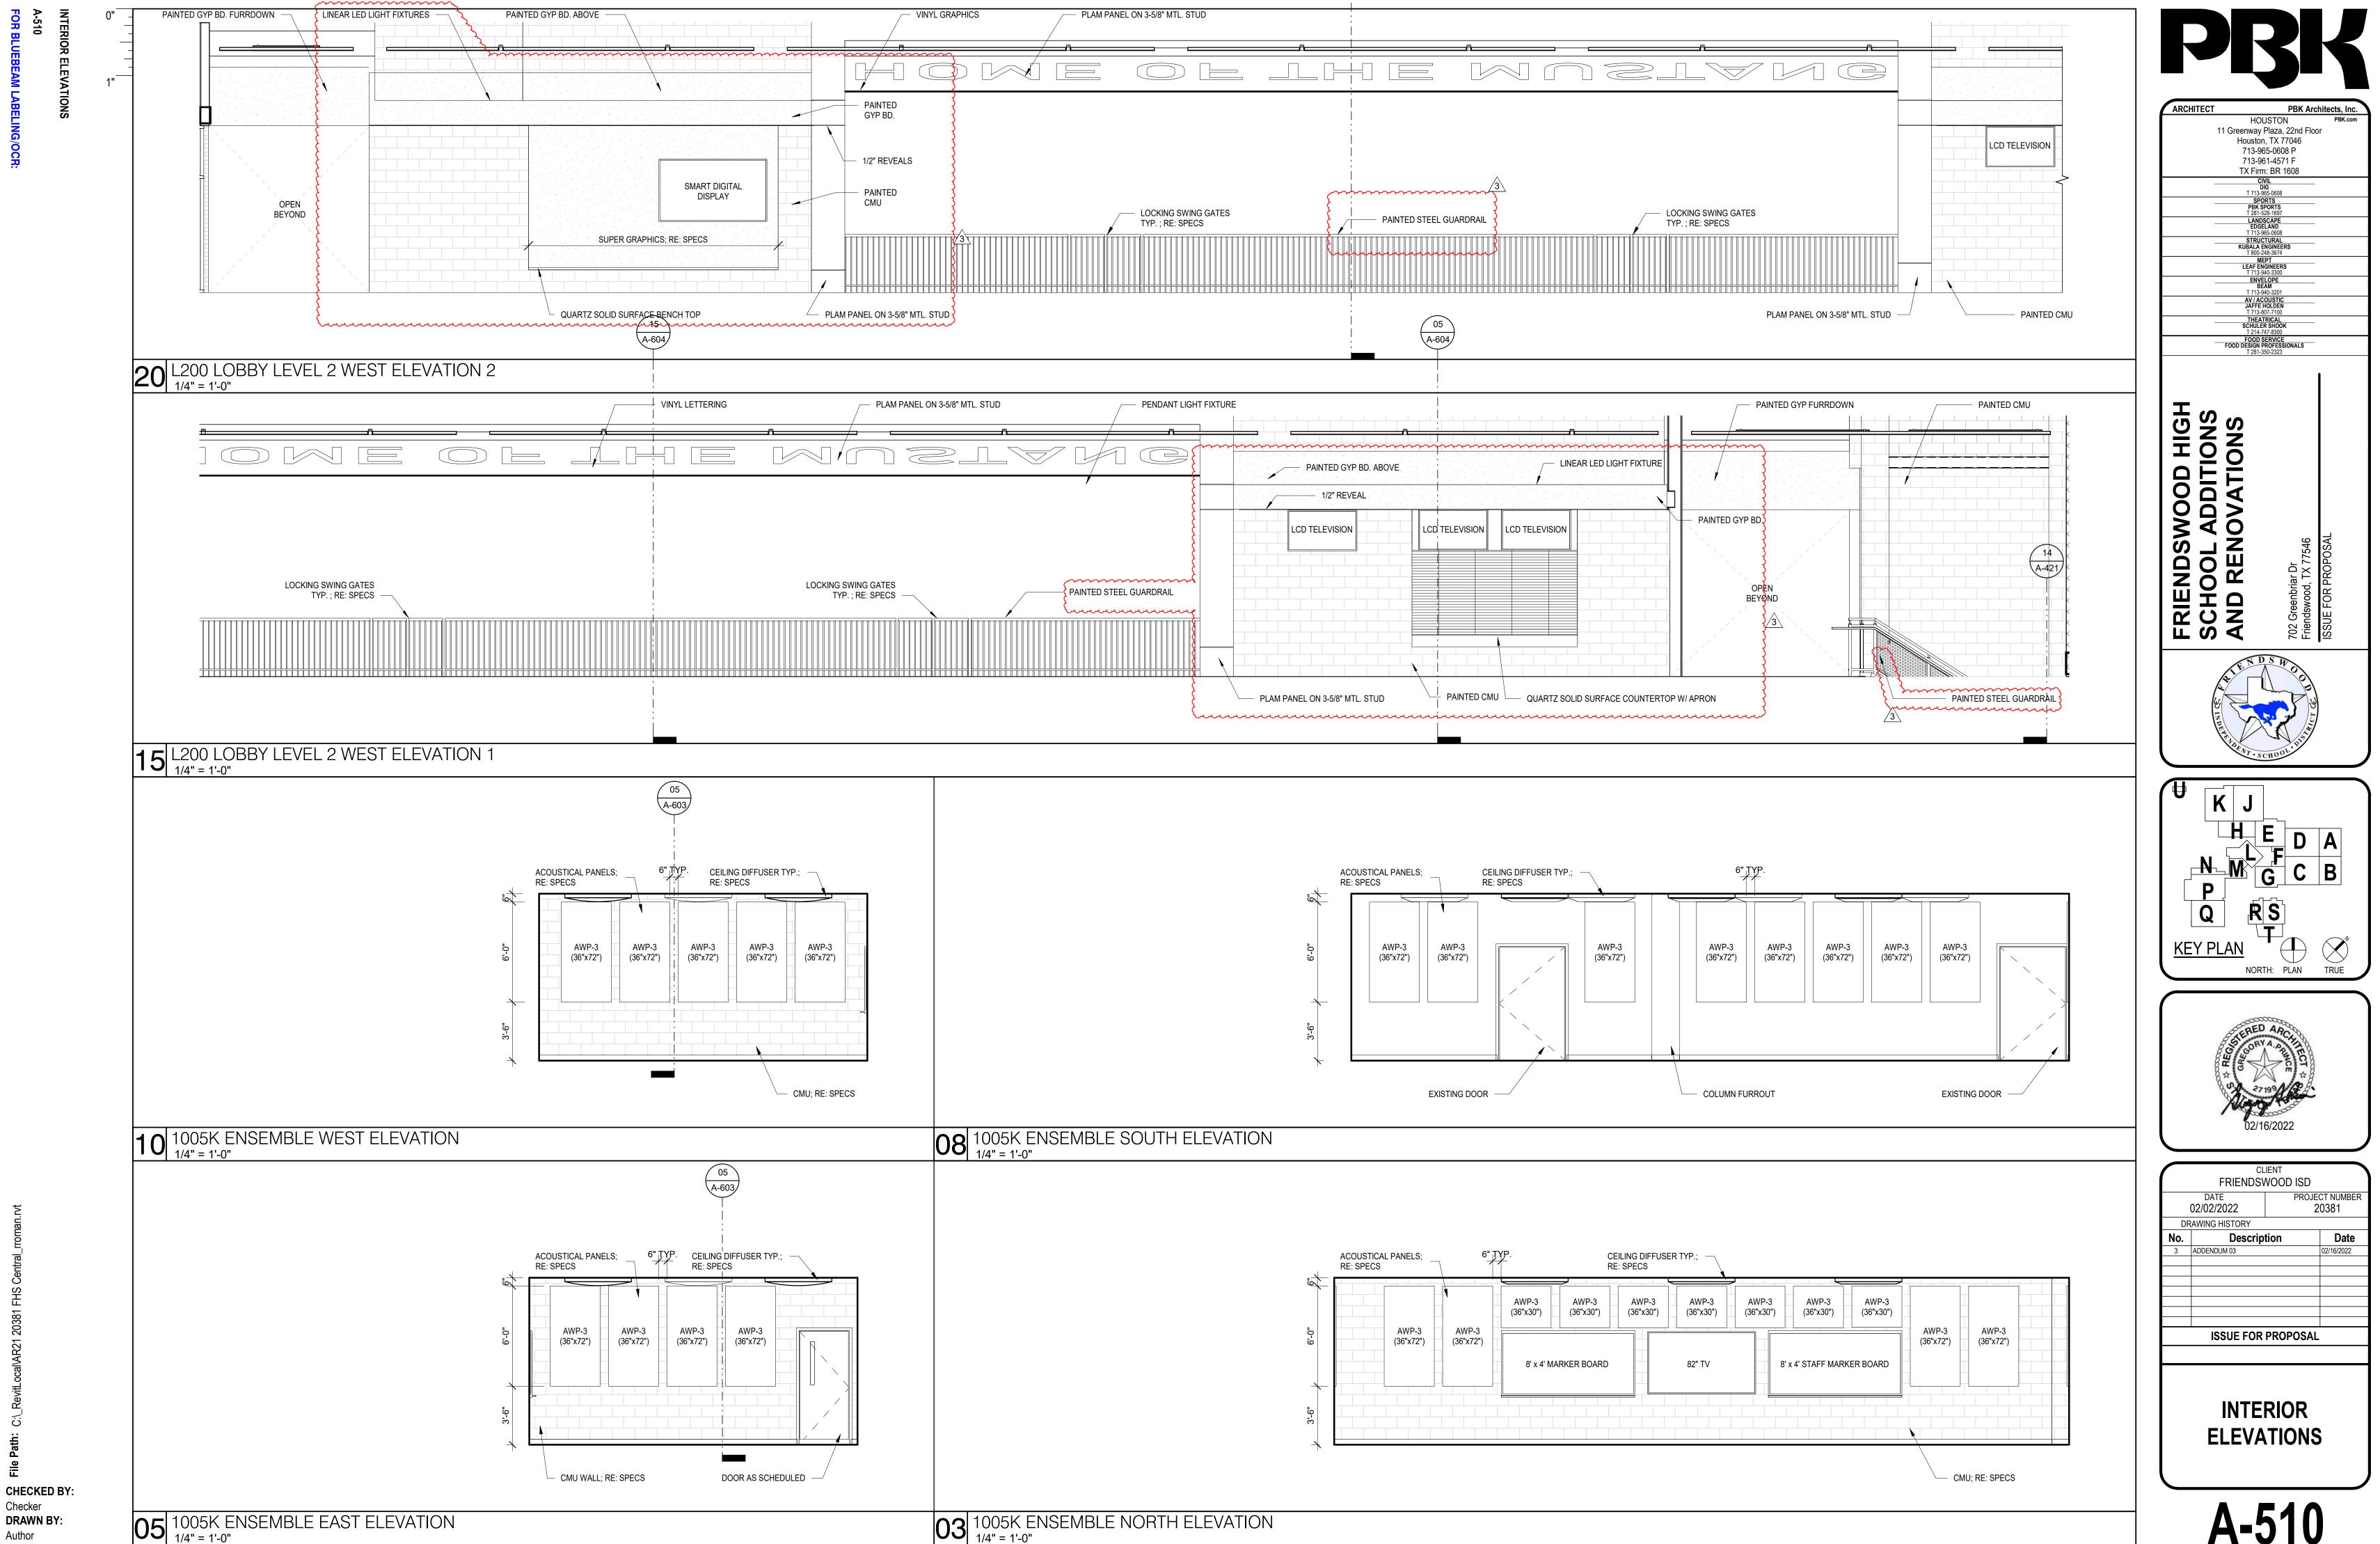

Checker

Author Plot Stamp:


2/16/2022 10:12:56 PM


HOUSTON 11 Greenway Plaza, 22nd Floor Houston, TX 77046 713-965-0608 P 713-961-4571 F TX Firm: BR 1608 FRIENDSWOOD HIGH SCHOOL ADDITIONS AND RENOVATIONS KJ KEY PLAN NORTH: PLAN TRUE

FRIENDSWOOD ISD PROJECT NUMBER 20381 02/02/2022 DRAWING HISTORY ISSUE FOR PROPOSAL **INTERIOR**

ELEVATIONS


CHECKED BY: Checker DRAWN BY: Author Plot Stamp: 2/16/2022 10:32:38 PM

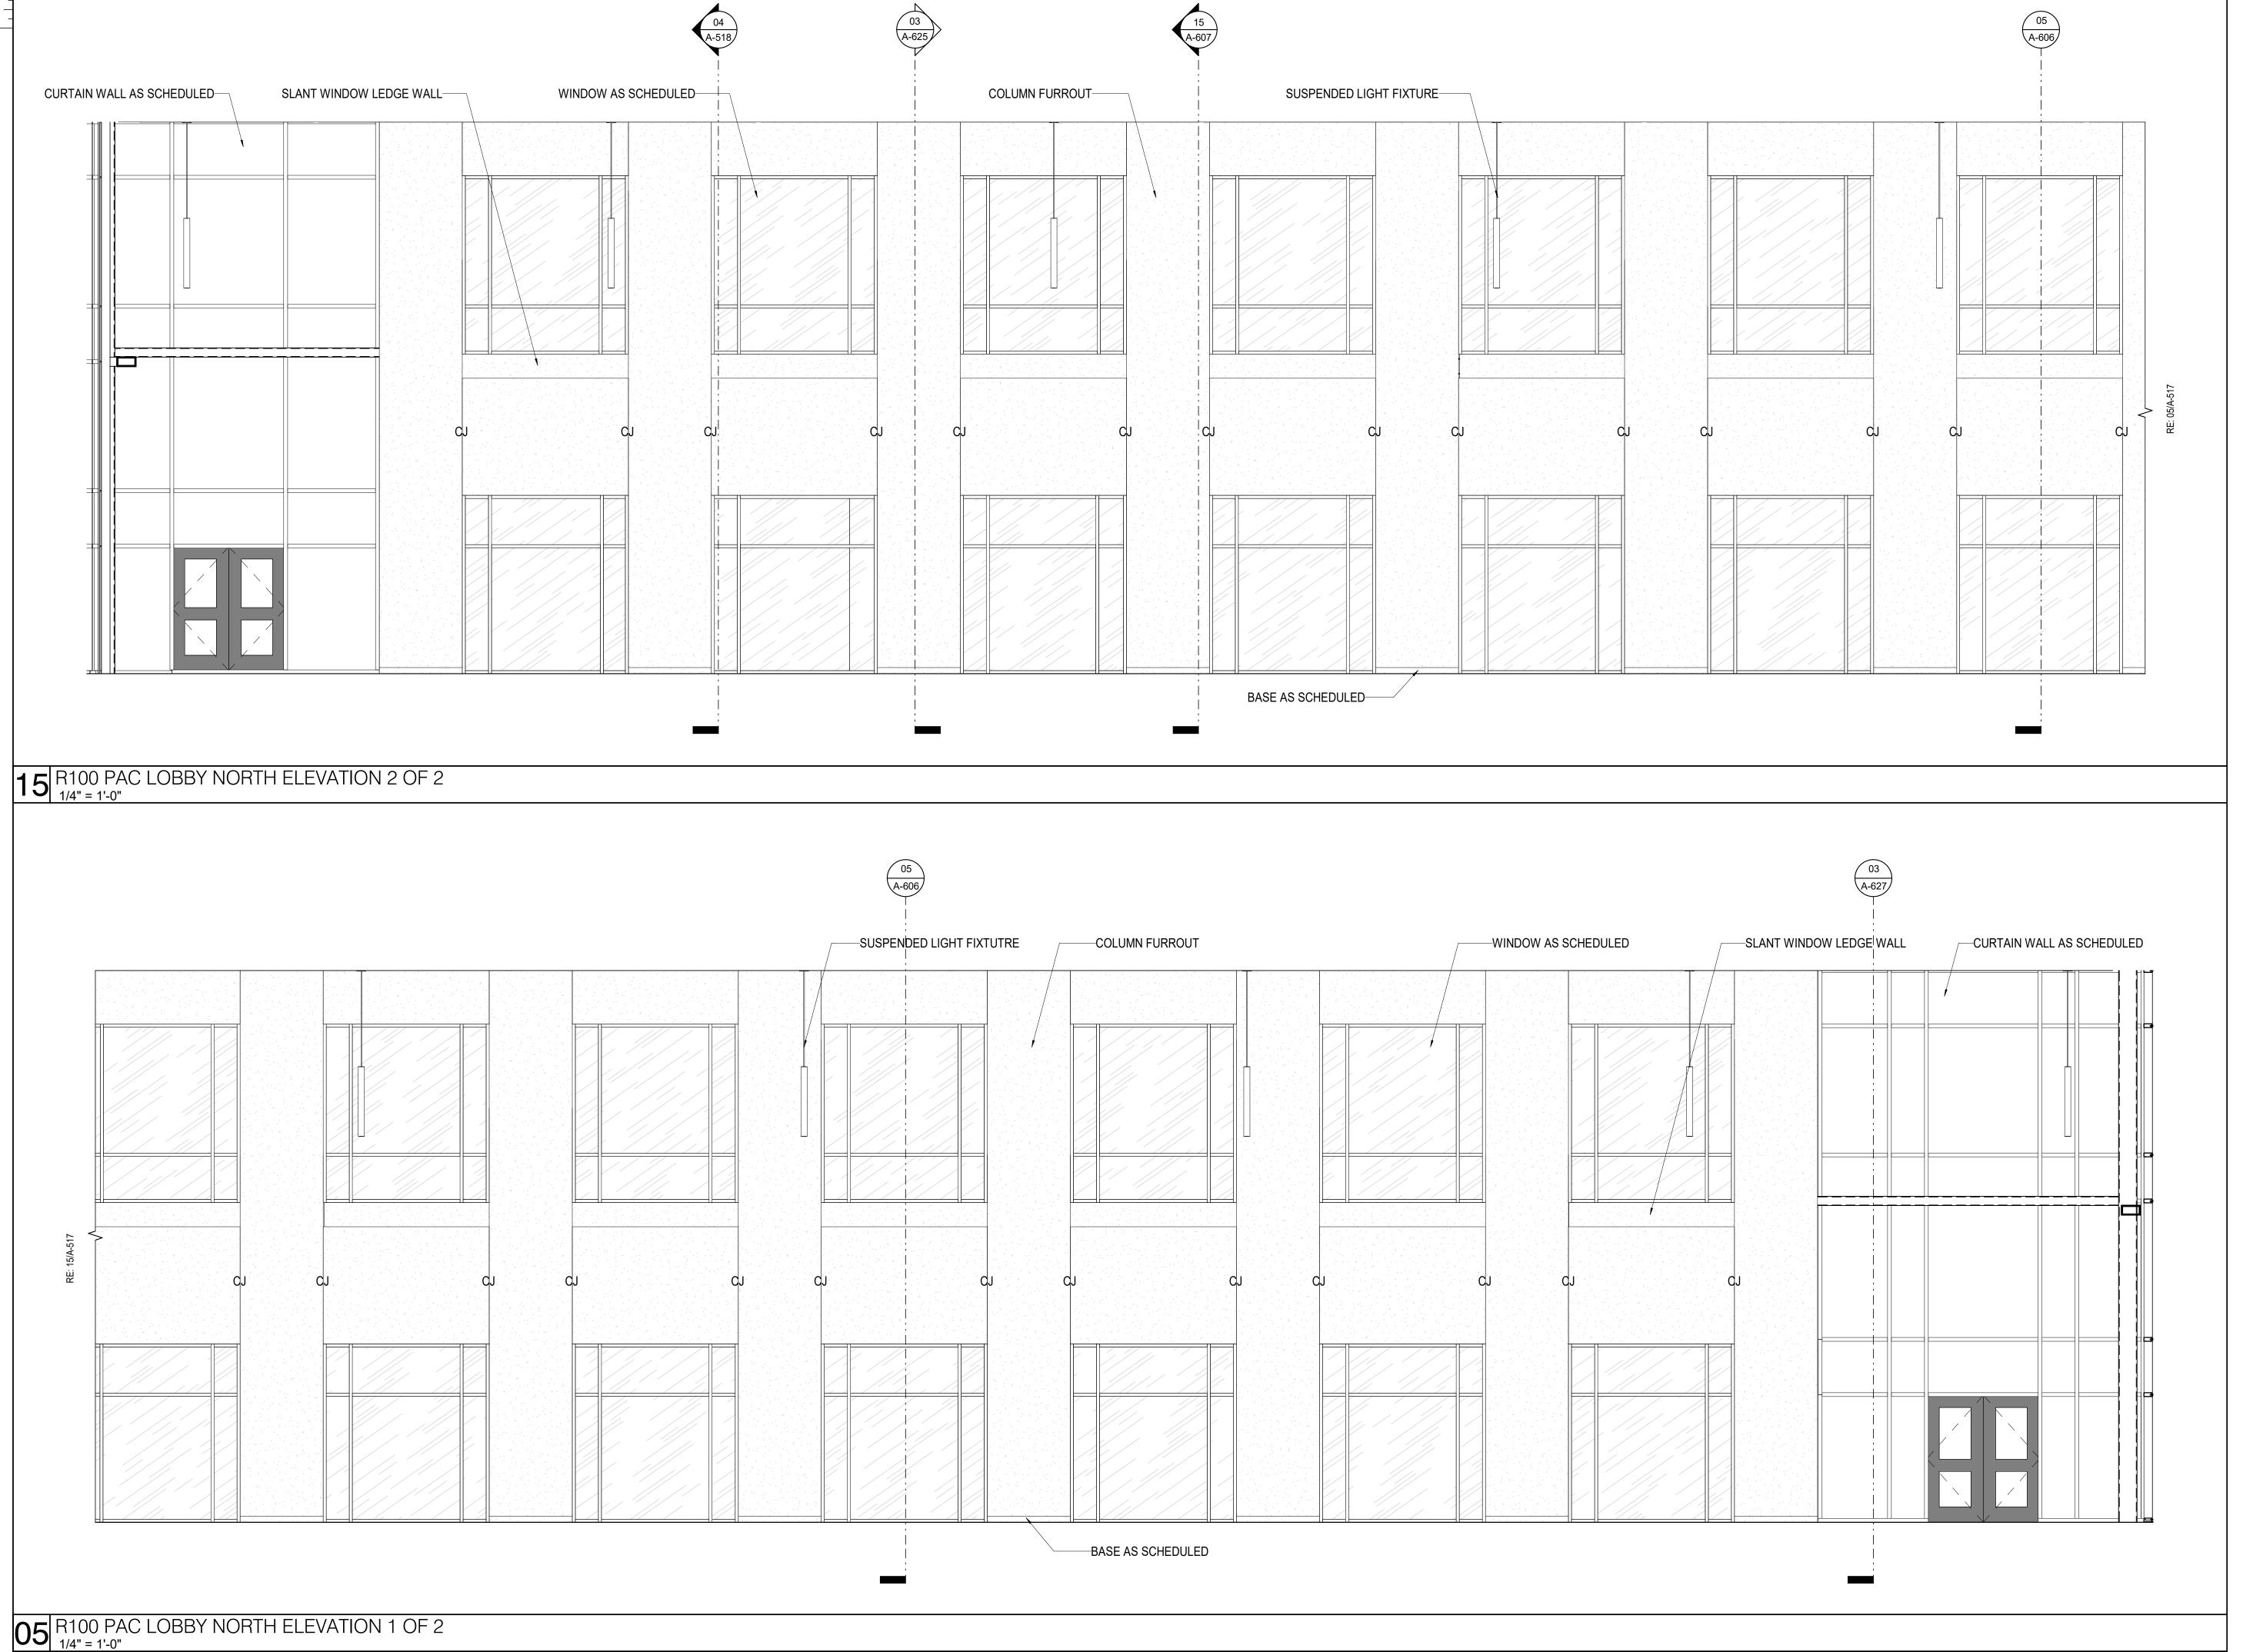


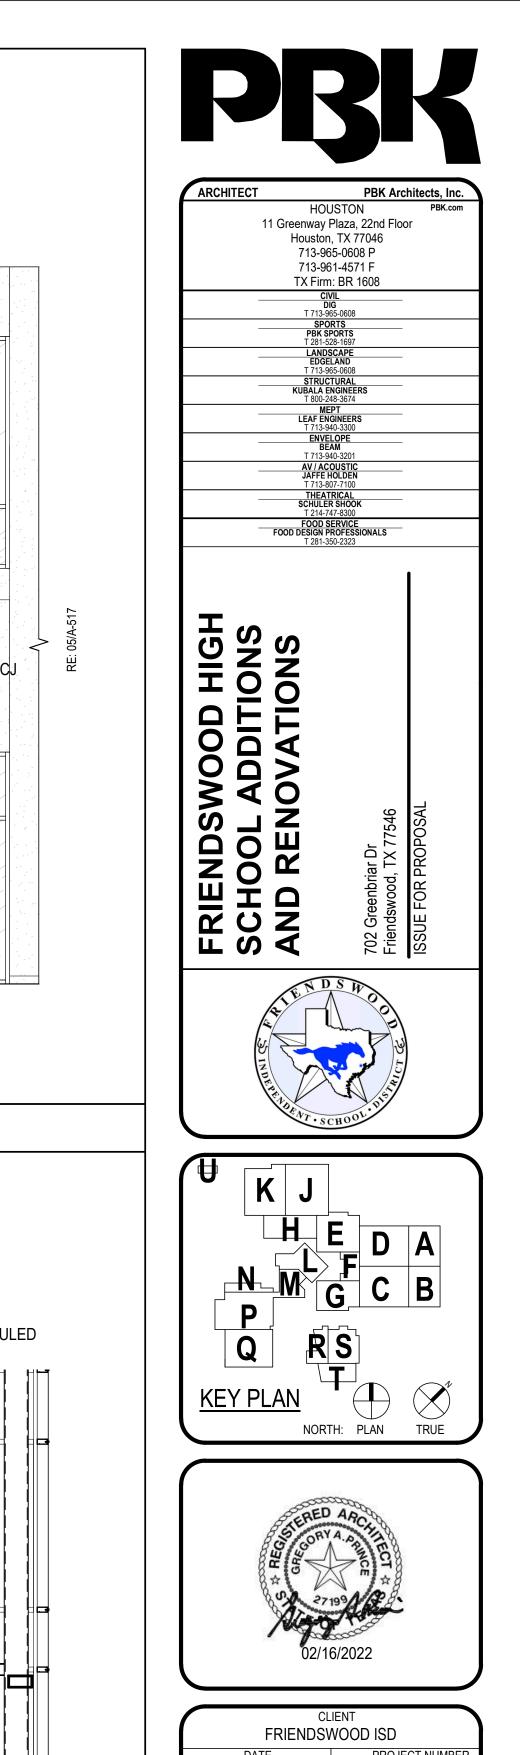


	Cl	JENT		
	FRIENDSWOOD ISD			
DATE PROJECT NUMBER 02/02/2022 20381				
DI	RAWING HISTORY			
No.	Descrip	tion	Date	
3	ADDENDUM 03		02/16/2022	
	ISSUE FOR PROPOSAL			
i				


INTERIOR ELEVATION

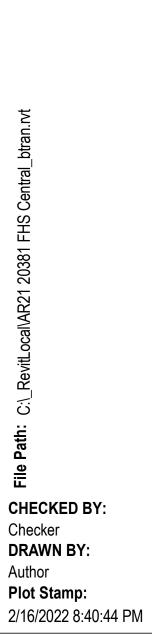

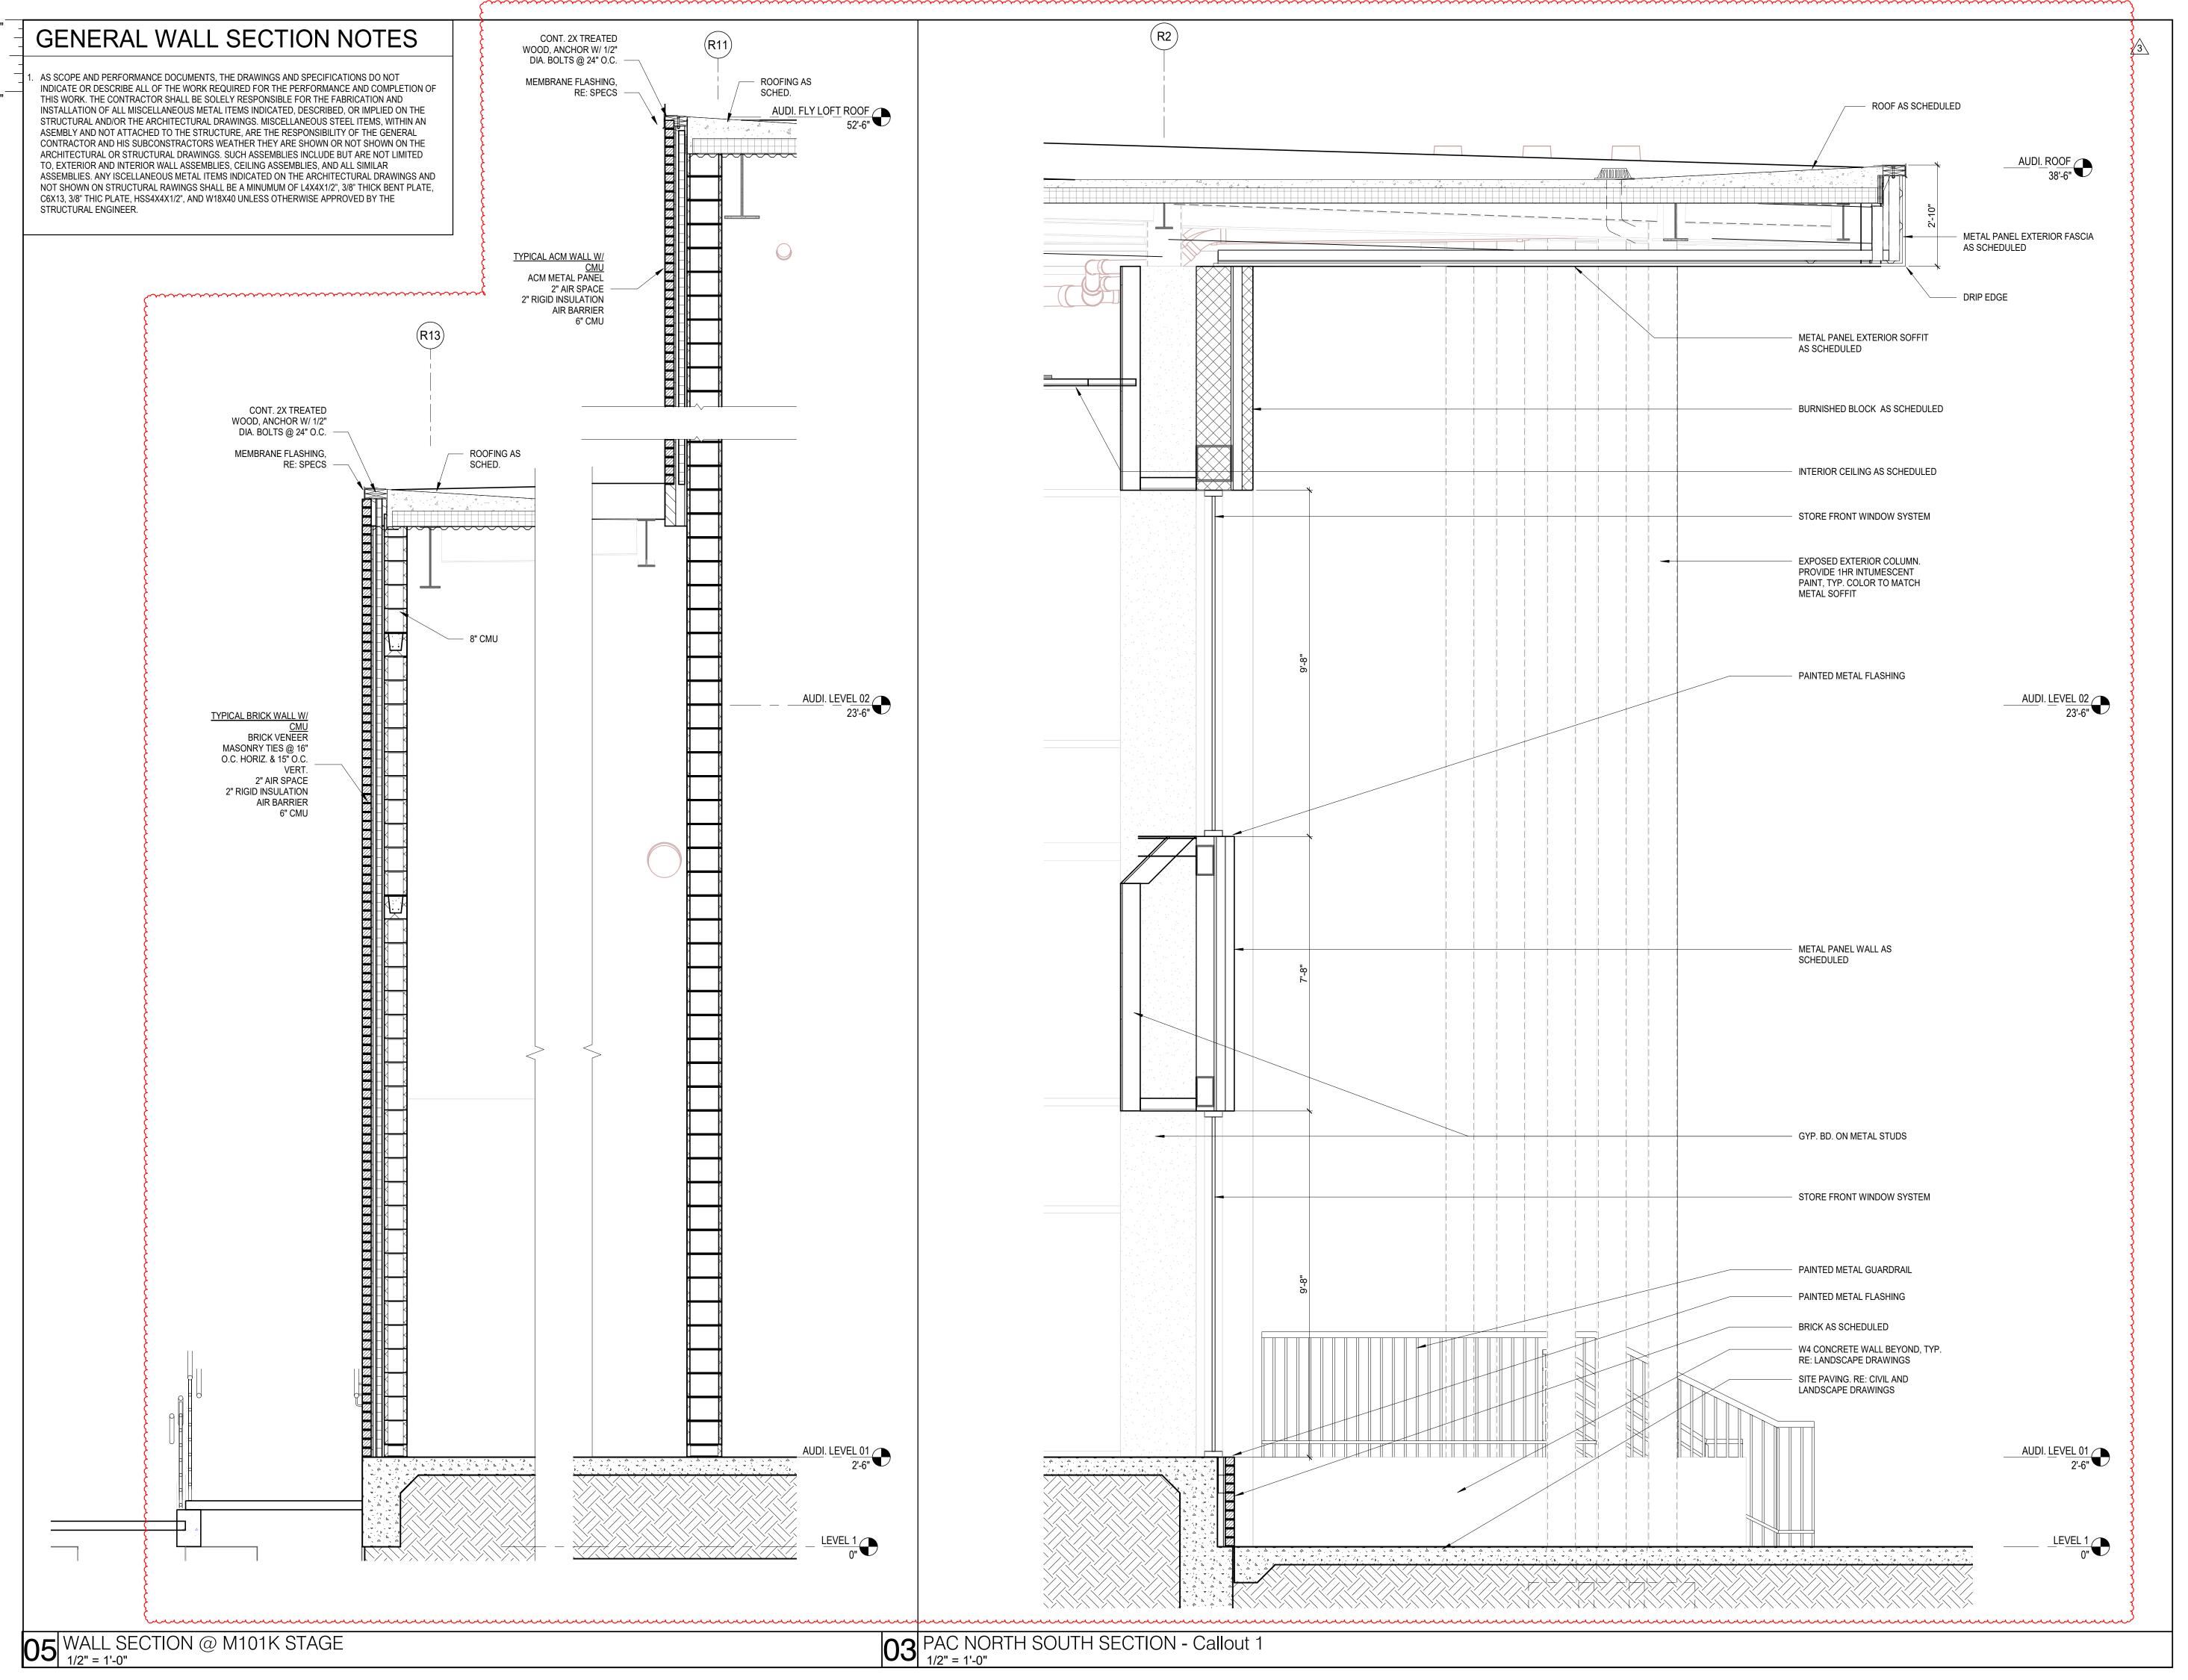

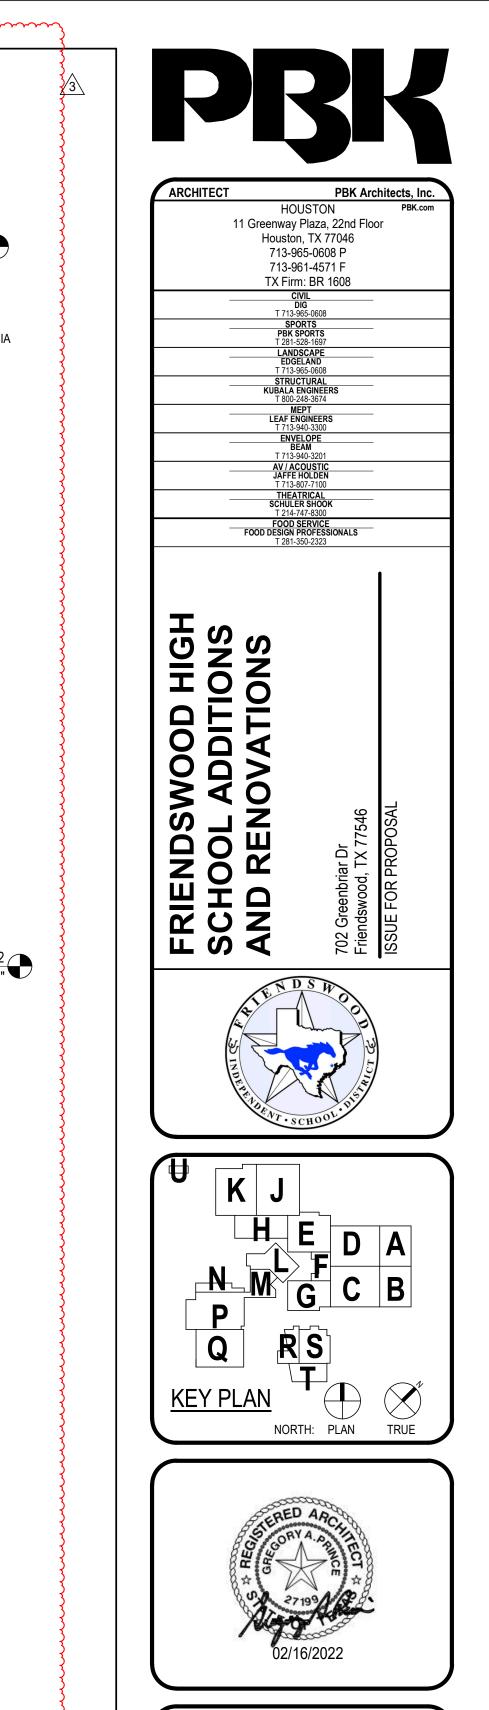



	-	IENT	
	FRIENDS	WOOD ISD	
	DATE		CT NUMB
	02/02/2022		20381
DI	RAWING HISTORY		T
No.	Descrip	tion	Dat
3	ADDENDUM 03		02/16/2022
	ISSUE FOR	PROPOSAL	
	WALL CO		NC
	WALL SE		Cr

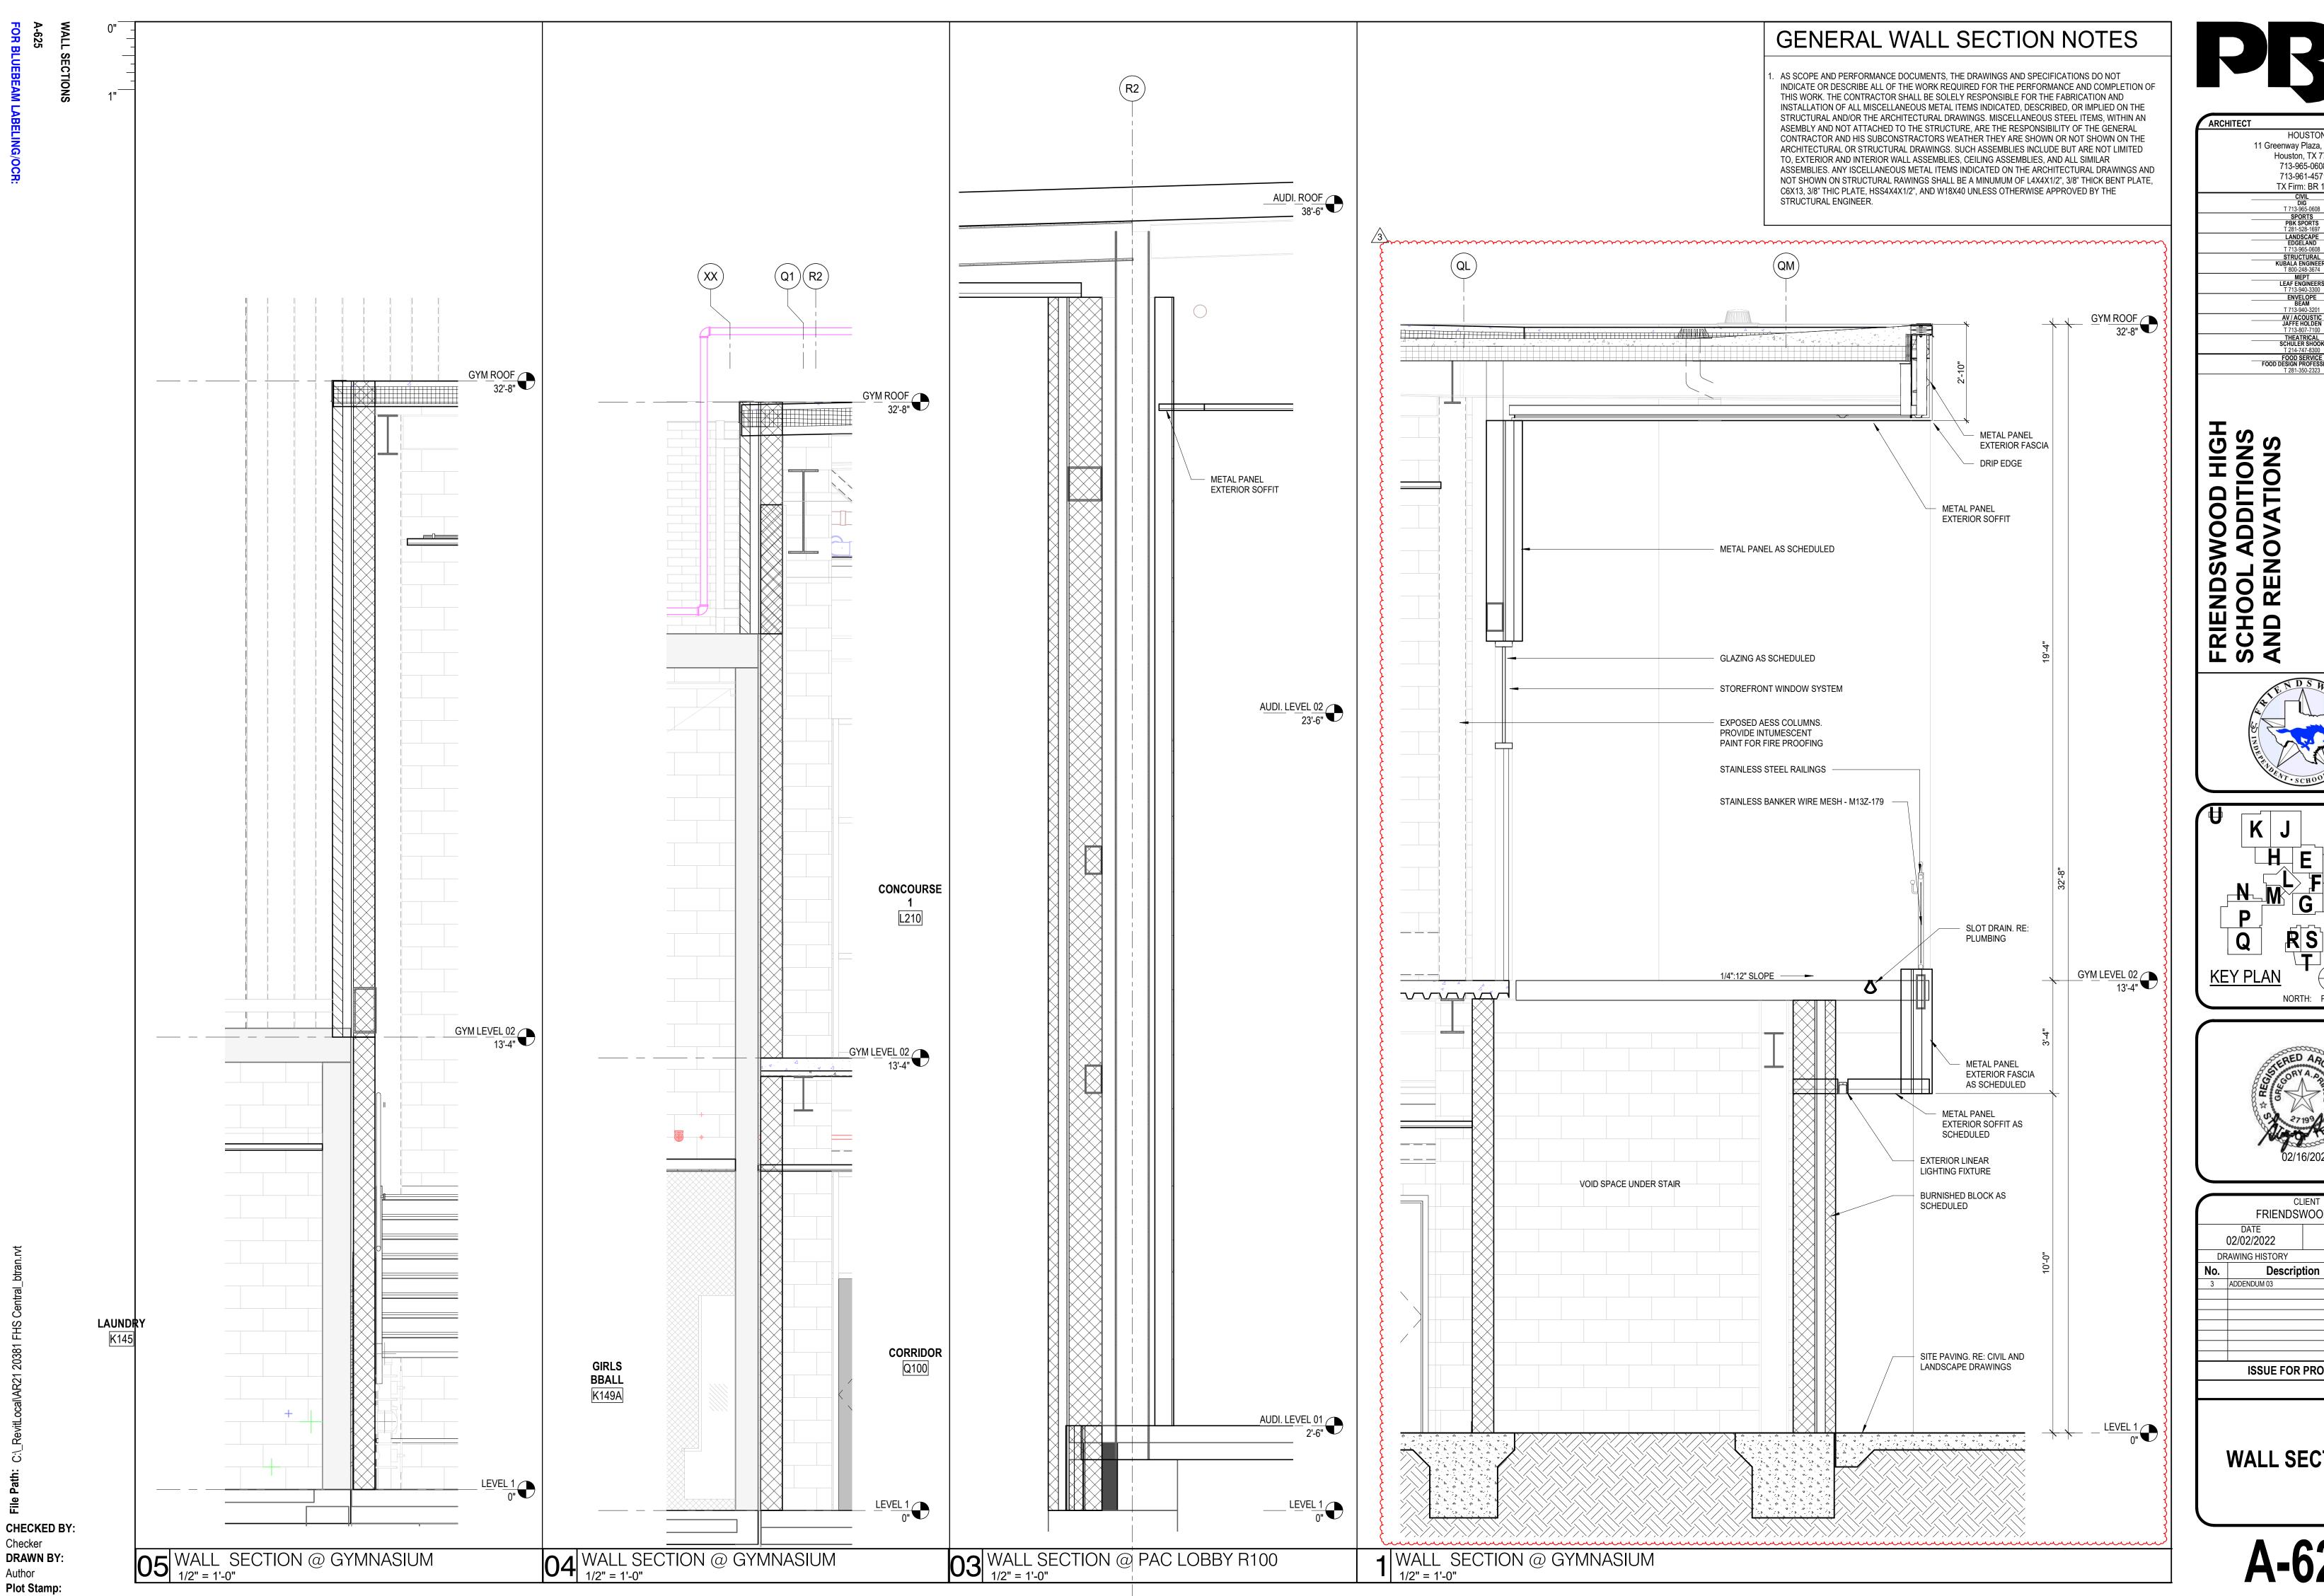


2/16/2022 8:40:06 PM


HOUSTON 11 Greenway Plaza, 22nd Floor Houston, TX 77046 713-965-0608 P 713-961-4571 F TX Firm: BR 1608

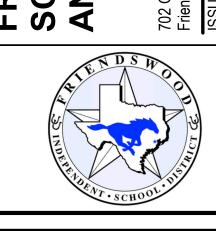

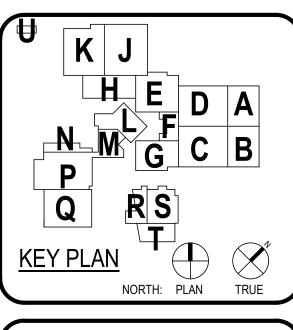

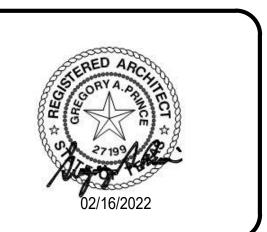

		IENT		
		WOOD ISD		
DATE PRO 02/02/2022			CT NUMBER 0381	
DF	RAWING HISTORY			
No.	Descrip	Description		
3	ADDENDUM 03		02/16/2022	
	ISSUE FOR	PROPOSAL		
WALL CECTIONS				
WALL SECTIONS				

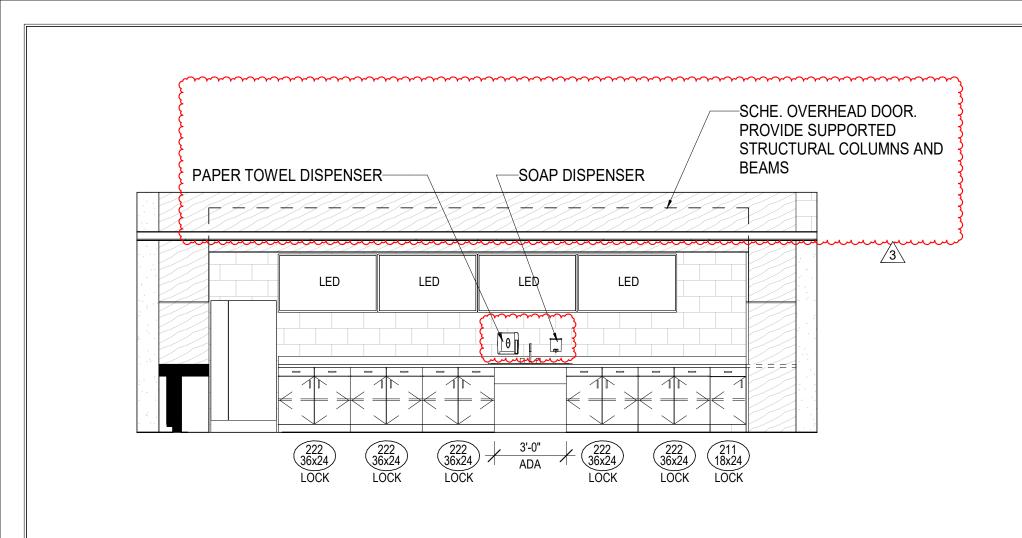

M102 CONCESSION - SOUTH ELEVATION 1/4" = 1'-0"

HOUSTON 11 Greenway Plaza, 22nd Floor Houston, TX 77046 713-965-0608 P 713-961-4571 F TX Firm: F-1608

PROJECT:

FRIENDSWOOD HIGH SCHOOL ADDITIONS AND **RENOVATIONS**

CURRENT REVISION DESCRIPTION: ADDENDUM 03

SCALE: DRW BY: CHK BY:

1/4" = 1'-0" Author Checker PROJECT No:

20381

RFI No:

REF SHEET:

2/16/2022 10:15:41 PM

SKETCH NUMBER:

SK-03



02/16/2022

HOUSTON 11 Greenway Plaza, 22nd Floor Houston, TX 77046 713-965-0608 P 713-961-4571 F TX Firm: BR 1608 FRIENDSWOOD HIGH SCHOOL ADDITIONS AND RENOVATIONS K J —DOOR & FRAME AS SCHEDULED KEY PLAN NORTH: PLAN TRUE QUARTZ SOLID SURFACE COUNTERTOP W/ APRON—— QUARTZ SOLID SURFACE COUNTERTOP W/ APRON 07 L201 CONCESSIONS WEST ELEVATION CLIENT FRIENDSWOOD ISD PROJECT NUMBER 20381 DATE 02/02/2022 DRAWING HISTORY OVERHEAD DOOR AS SCHEDULED DOOR & FRAME AS SCHEDULED

FILLER PANEL

02 L201 CONCESSIONS EAST ELEVATION

KNEE SPACE

ISSUE FOR PROPOSAL CASEWORK ELEVATIONS

CHECKED BY: Checker DRAWN BY: Author Plot Stamp: 2/16/2022 10:13:03 PM

OPEN SPACE

QUARTZ SOLID SURFACE COUNTERTOP W/ APRON

05 R100A CONCESSION - WEST

QUARTZ SOLID SURFACE COUNTERTOP W/ APRON—

04 R100A CONCESSION - EAST 1/4" = 1'-0"



ARCHITECT PBK Architects,

HOUSTON PBK 11 Greenway Plaza, 22nd Floor Houston, TX 77046

713-965-0608 P
713-965-0608 P
713-961-4571 F

TX Firm: BR 1608

CIVIL DIG T713-965-0608

SPORTS
PBK SPORTS
**I 281-528-1697

LANDSCAPE
EDGELAND
**T13-965-0608

STRUCTURAL
KUBALA ENGINEERS
**T 800-248-3674

MEPT

LEAF ENGINEERS
**T 713-940-3300

ENVELOPE**

BEAM
**T 713-940-3301

AV / ACOUSTIC JAFFE HOLDEN T713-807-7100


THEATRICAL
SCHULER SHOOK
**T 214-747-8300


FOOD SERVICE**


FOOD DESIGN PROFESSIONALS**
T 281-350-2323

T 281-350-2323

FRIENDSWOOD HIGH SCHOOL ADDITIONS AND RENOVATIONS

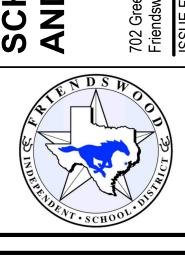

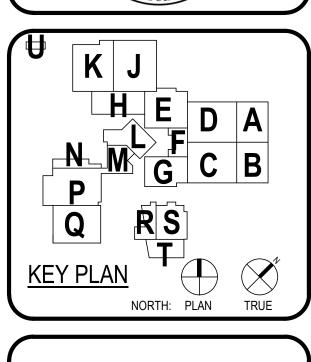

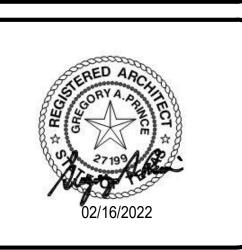


	-	IENT		
	FRIENDSV	VOOD ISD		
	DATE 02/02/2022		ROJECT NUMBER 20381	
DI	RAWING HISTORY			
No.	Descrip	Description		
3	ADDENDUM 03		02/16/2022	
ISSUE FOR PROPOSAL				

CASEWORK SECTIONS

A-847

CHECKED BY:
Checker
DRAWN BY:
Author
Plot Stamp:
2/16/2022 10:13:05 PM

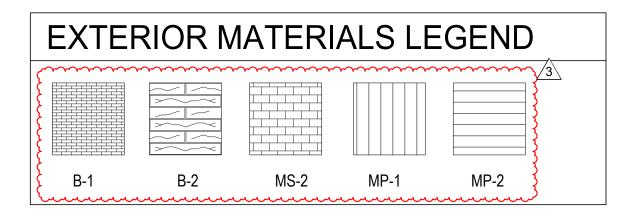

~20381-FRIENDSWOOD-HIGH-SCHOOL ~SCHEDULE-OF-FINISHES

ITEM	MANUFACTURER	DESCRIPTION	COLOR	SIZE	LOCATION	NOTES
MASONRY						
B-1	ENDICOTT	SMOOTH	MEDIUM IRON SPOT 46	KING	FIELD	GROUT TBD
B-2	CLOUD CERAMICS	SMOOTH	MIDNIGHT IS	KING	UNDER THE WINDOW BAYS ON THE PAC LOBBY	0.0000
MS-2	UPCHURCH KIMBROUGH	SALT AND PEPPER	BURNISH BLOCK	8"x16"	PAC ENTRY WALL, GYM UNDER STAIRS, PAC EXTERIOR	RUNNING BOND
GLASS						
G-1	SUNGUARD	SNX62/27	crystal blue	200.000	PAC AND GYM ADDITIONS	
METAL						
M-1	KAWNEER	ANODIZED	DARK BRONZE		MULLIONS	ALL ADDITIONS
MP-1	BERRIDGE L PANEL		CHARCOAL GREY		PAC AND GYM SOFFITS AND FASCIA	
MP-2	BERRIDGE HR-16		CHARCOAL GREY		GYM ELEVATION, BETWEEN WINDOWS ON PAC, PAC FLY LOFT	PAINT EXTERIOR COLUMNS TO MATCH THIS COLOR.



HOUSTON
11 Greenway Plaza, 22nd Floor
Houston, TX 77046
713-965-0608 P
713-961-4571 F
TX Firm: F-1608

PROJECT:

FRIENDSWOOD HIGH SCHOOL ADDITIONS AND RENOVATIONS

CURRENT REVISION DESCRIPTION: ADDENDUM 03

SCALE: DRW BY: CHK BY:

1/8" = 1'-0" NE BT

PROJECT No:

20381

RFI No:

REF SHEET: A-501 - A-504

AF100

2/16/2022 10:56:09 AM

SKETCH NUMBER:

SK-04



02/16/2022